


11  
8.5  
8.5  
11  
17

11  
8.5  
8.5  
11  
17

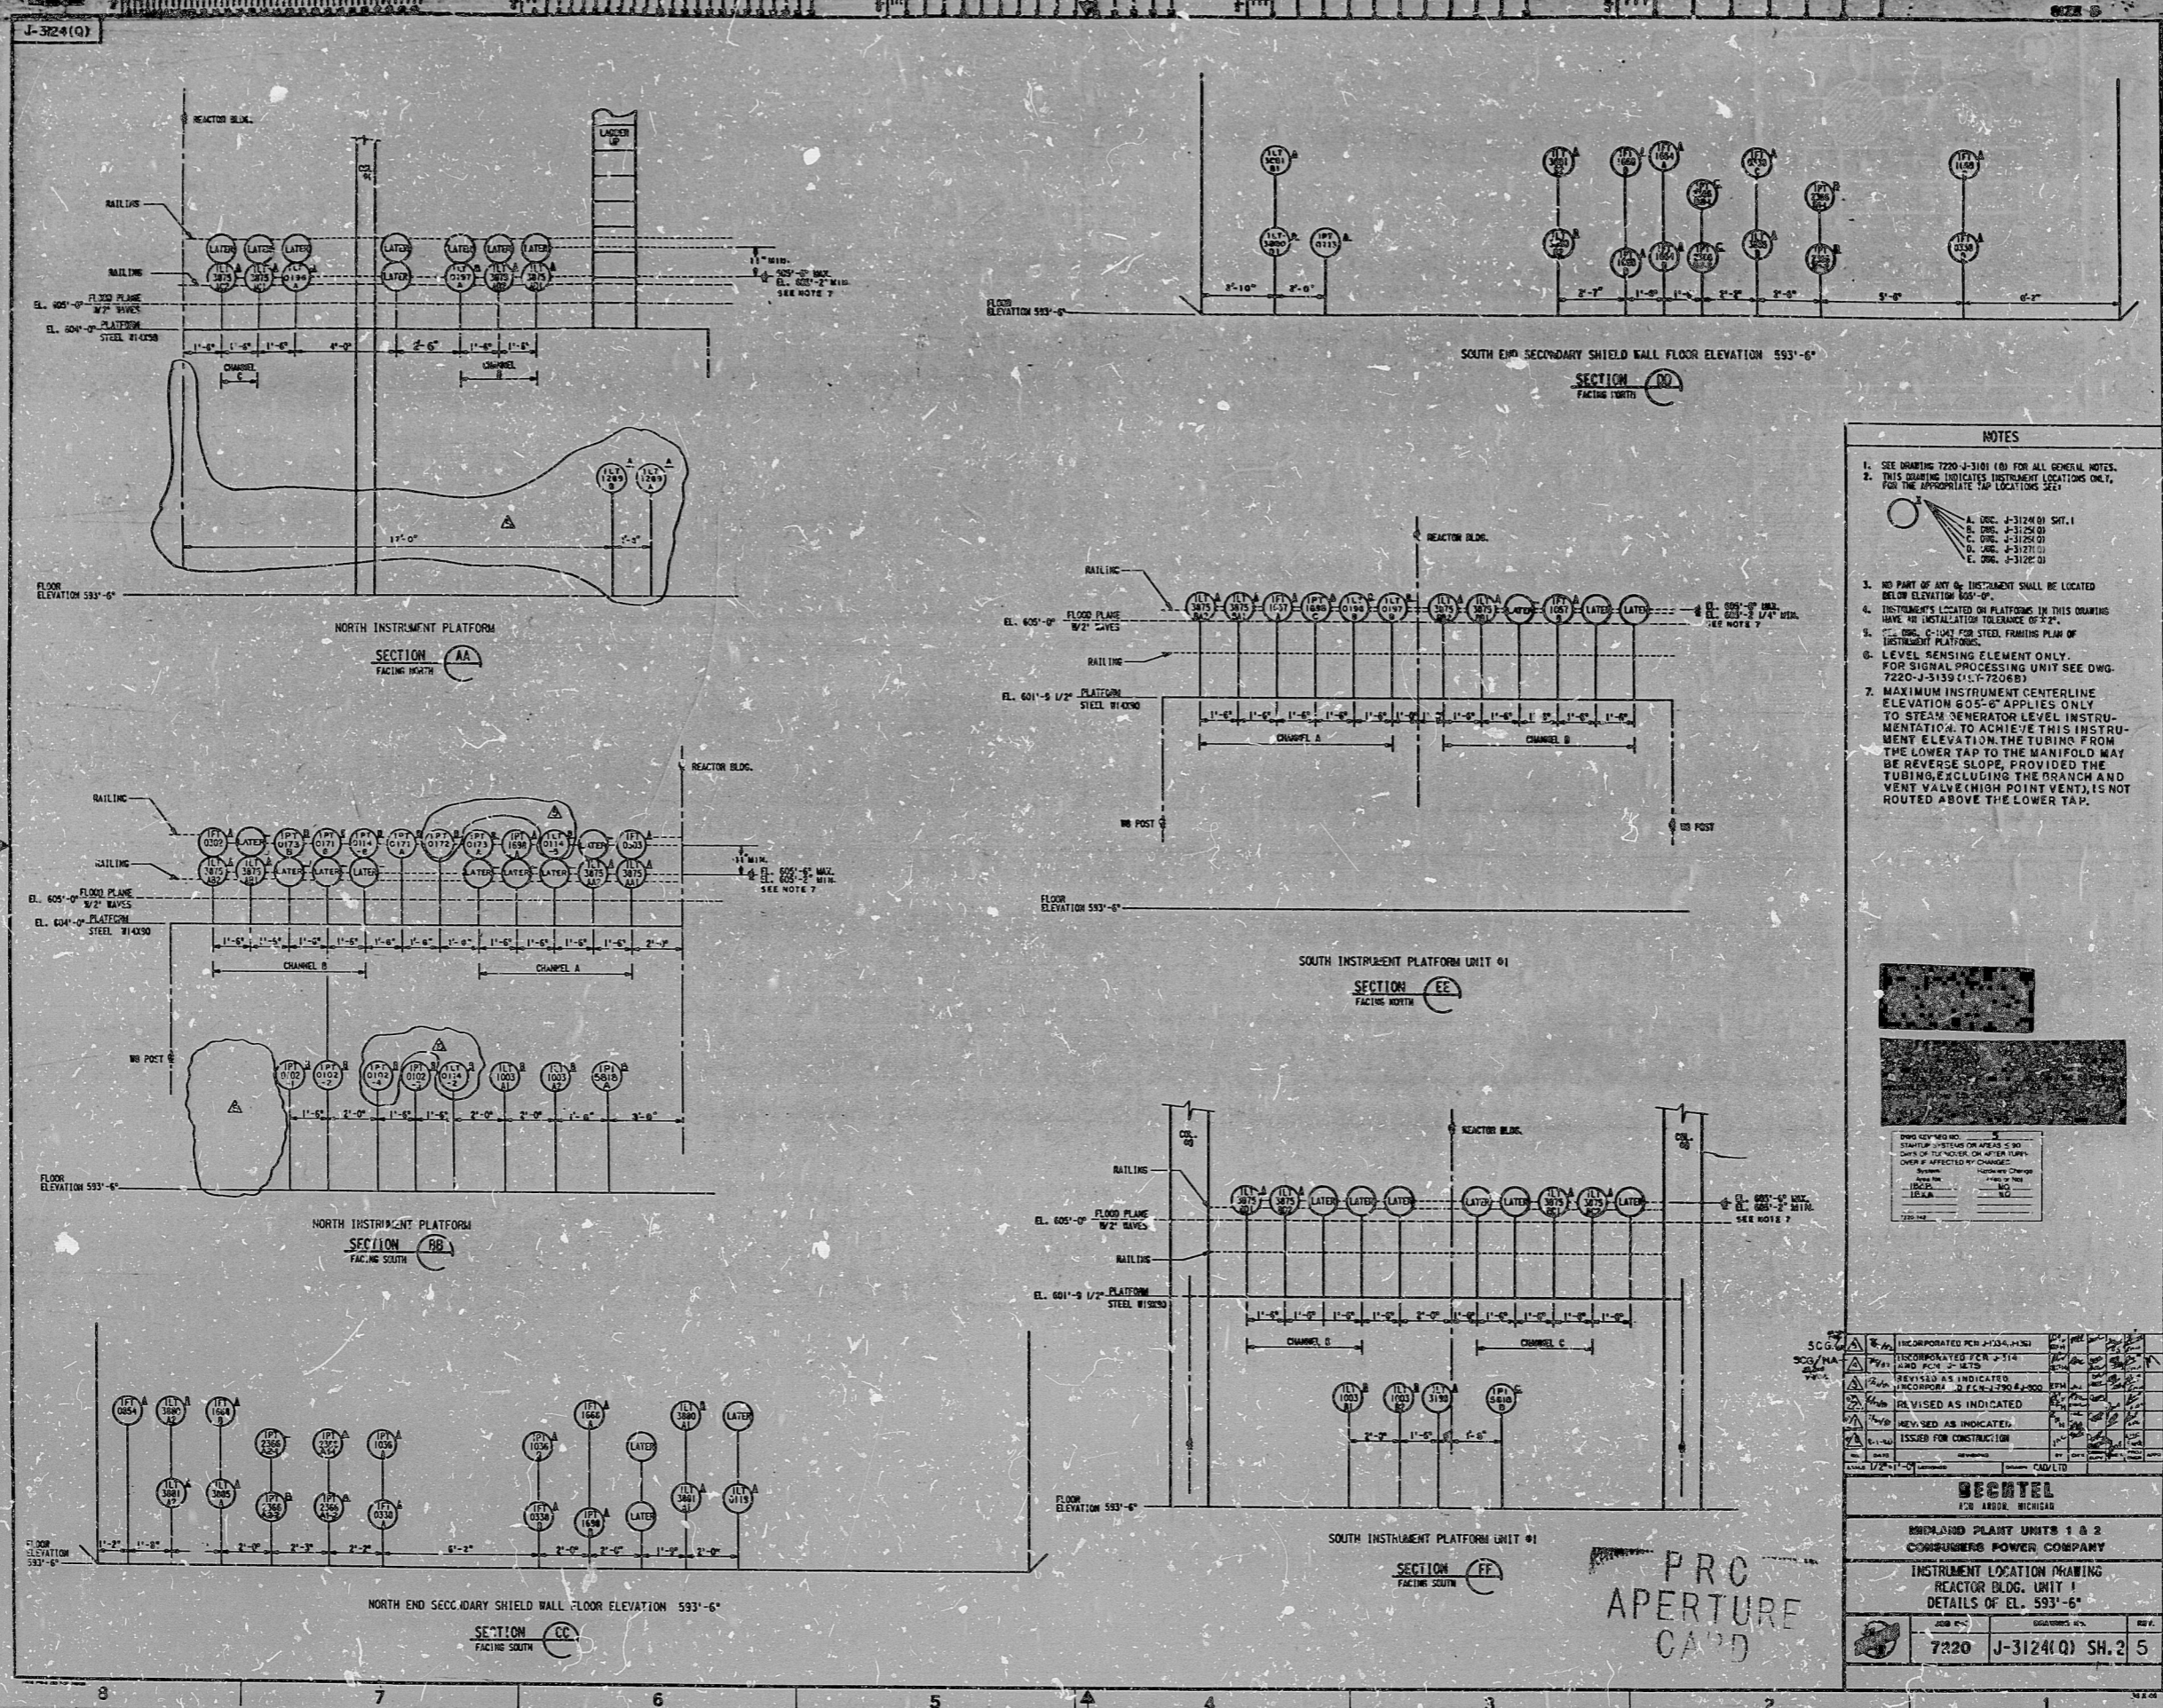


NOTES

- THIS DRAWING INDICATES INSTRUMENT LOCATIONS ONLY. FOR THE APPROPRIATE TAP LOCATIONS SEE:


- MAXIMUM INSTRUMENT CENTERLINE ELEVATION 605'-6" APPLIES ONLY TO STEAM GENERATOR LEVEL INSTRUMENTATION. TO ACHIEVE THIS INSTRUMENT ELEVATION, THE TUBING FROM THE LOWER TAP TO THE MANIFOLD MAY BE REVERSE SLOPE, PROVIDED THE TUBING, EXCLUDING THE BRANCH AND VENT VALVE (HIGH POINT VENT), IS NOT ROUTED ABOVE THE LOWER TAP.

 

SCG...  
SCG/HA  
...

NO.	DESCRIPTION	DATE
1	ISSUED FOR CONSTRUCTION	

MIDLAND PLANT UNITS 1 & 2 CONSUMERS POWER COMPANY	
INSTRUMENT LOCATION DRAWING REACTOR BLDG. UNIT 1 DETAILS OF EL. 593'-6"	
7220	J-3124(Q) SH. 2 5

PRO APERTURE CARD

**RIDS**

8302040444

