

17"

11"

8.5"

8.5"

11"

17"

17"

11"

8.5"

8.5"

11"


17"

INSTRUMENT LOCATION DRAWING REVISION SHEET

MIDLAND PLANT UNITS 1 & 2
DRAWING 7220-J-312G (A) REV. 10

CONSUMERS POWER COMPANY
DATE 11-5-82

ZONE	EXPLANATION OF REVISION
F3	CORRECTED TAP REFERENCE FOR IPT-1004 A1 4A2 PER FCM-J-1494

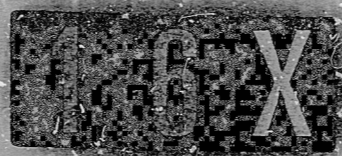

CERTIFICATE OF MICROFILMING

"I certify that the image contained on this frame was made in the normal and regular course of business on the date stated below and that it is an accurate reproduction of the document submitted to the contractor for filming by Bechtel Power Corporation."

11-11-82 Tony Smith Sue Crockett
DATE CAMERA OPERATOR CONTRACTOR SUPERVISOR

PRC
APERTURE
CARD

RIDS

8302040446

