



J-3134(O)

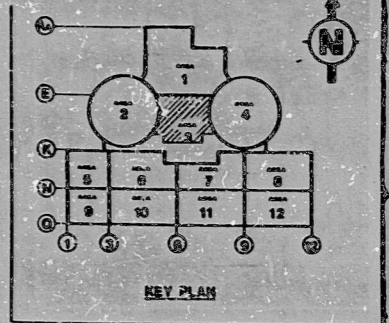

SYSTEM STATUS LEGEND

SYSTEM	ISS.	PAID	TESTED
SELECTOR VALVE SPRAY SYSTEM	4/25/54	2/13/54	
DECAY HEAT REMOVAL AND CORE FLOODING SYSTEM	1/20/57	6/28/54	
LIQUID WASTE SYSTEM	1/20/57	6/28/54	
FIRE PROTECTION SYSTEM	5/1/54	10/31/53	

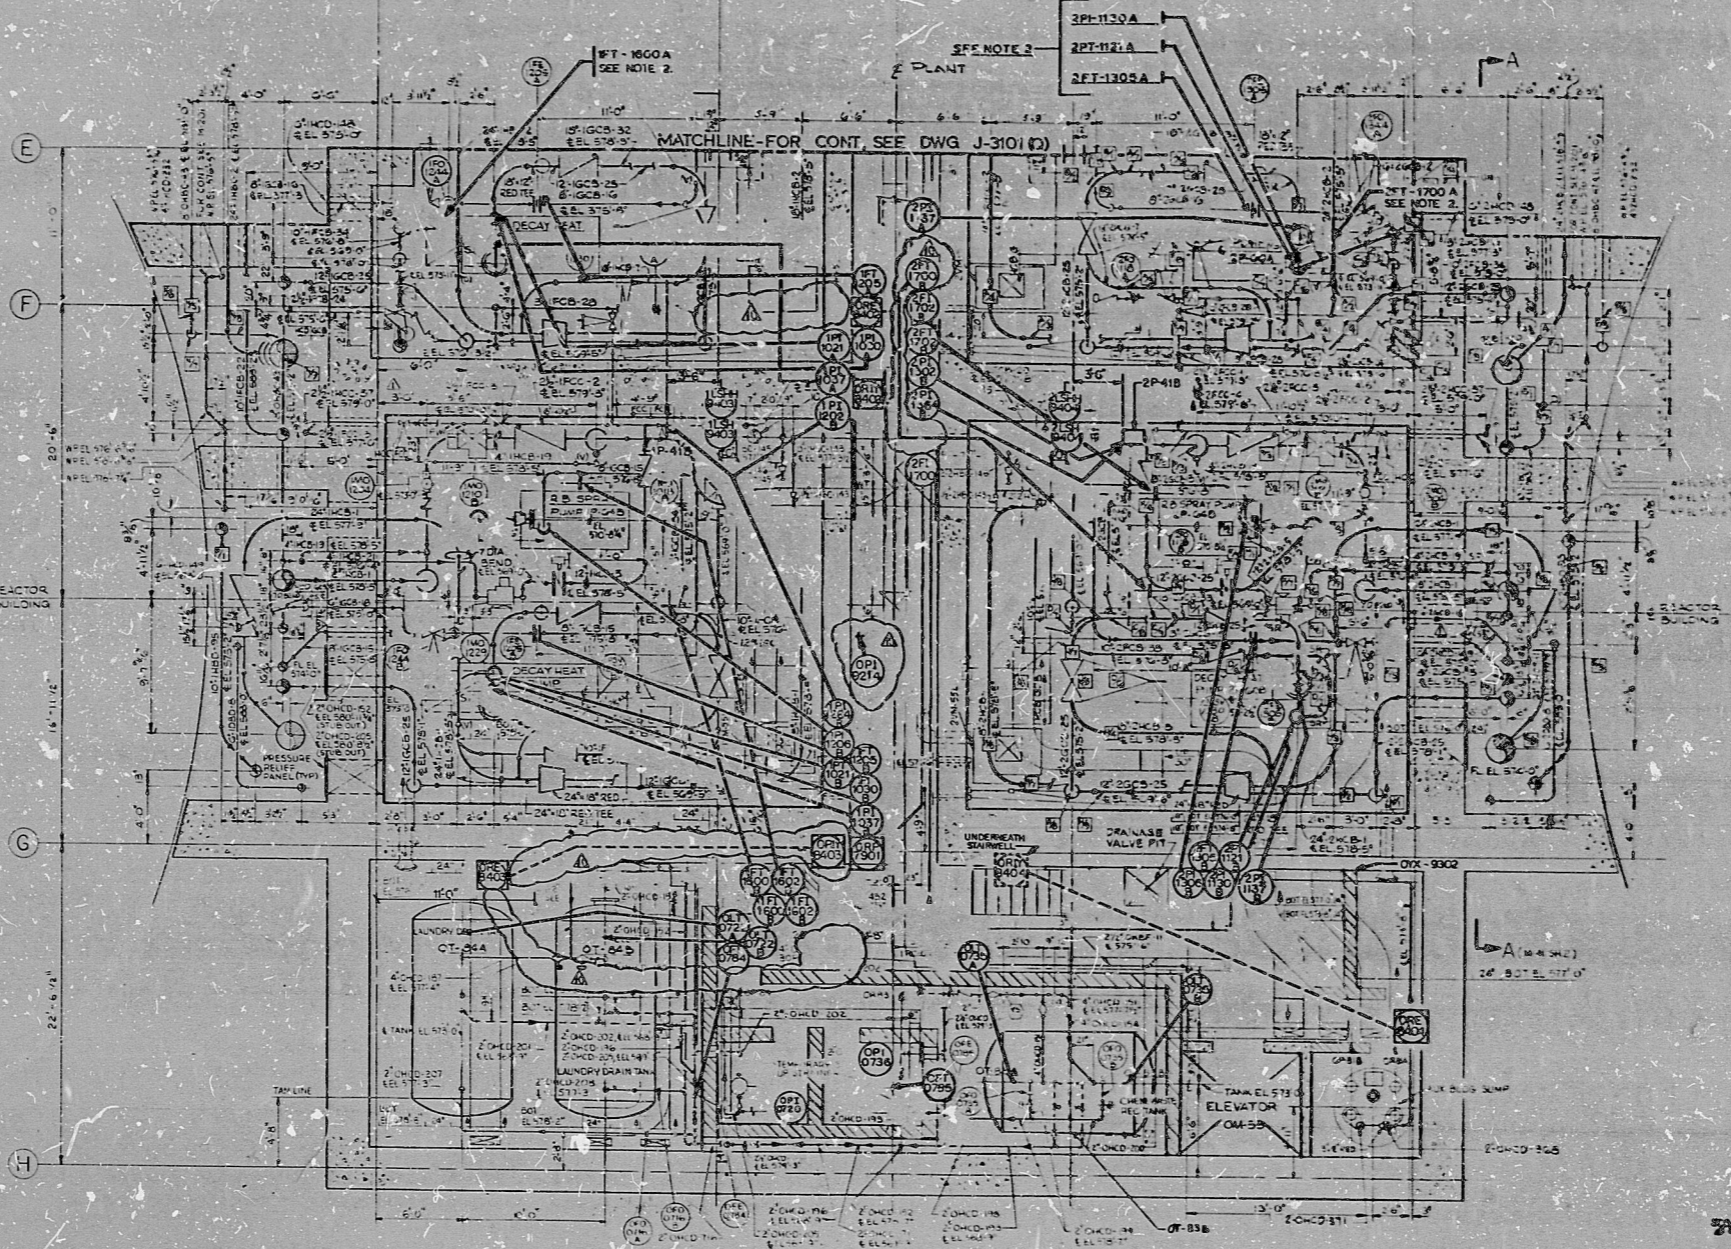

THIS DRAWING HAS BEEN PREPARED TO SHOW ALL OF THE LARGER PIPING SYSTEMS IN EACH AREA. THE OTHER SYSTEMS NOTED ON DRAWING, THESE SYSTEM LAYOUTS ARE ONLY TO BE USED AS A REFERENCE TO PERFORM OTHER ENGINEERING AND CONSTRUCTION TASKS.

INSTRUMENT LOCATION DWG NOTES:  
 1. SEE DWG 7220-J-3101(O) FOR ALL GENERAL NOTES.  
 2. THESE ARE TAP LOCATIONS ONLY. FOR INSTRUMENT LOCATION SEE DWG J-3101(O).  
 3. DELETED

PRC APERTURE CARD

NO.	DESCRIPTION	DATE	BY	CHKD.
1	INCORPORATED PCH'S #1000, #1001, #1002 AND #1003	4/25/54	J.M.	
2	INCORPORATED PCH'S #1004 AND #1005	4/25/54	J.M.	
3	REVISED AS INDICATED	5/1/54	J.M.	
4	ISSUED FOR CONSTRUCTION	5/1/54	J.M.	

BECHTEL  
 280 2808 BICHTER  
 MIDLAND PLANT UNIT 1 & 2  
 CONSTRUCTION PROJECT COMPANY

INSTRUMENT LOCATION DRAWING  
 AREA 3  
 PLAN OF EL. 568'-0"

7220	J-3134(O)	10
------	-----------	----

THIS DRAWING REPRODUCED FROM 7220-M-5010, REV. C. USE THIS DRAWING FOR INSTRUMENT LOCATION ONLY. FOR ALL OTHER DATA REFER TO APPLICABLE DRAWINGS.

**RIDS**

830204045

