
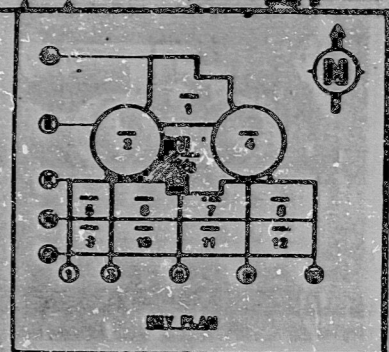


17"
11"
8.5"
8.5"
11"
17"

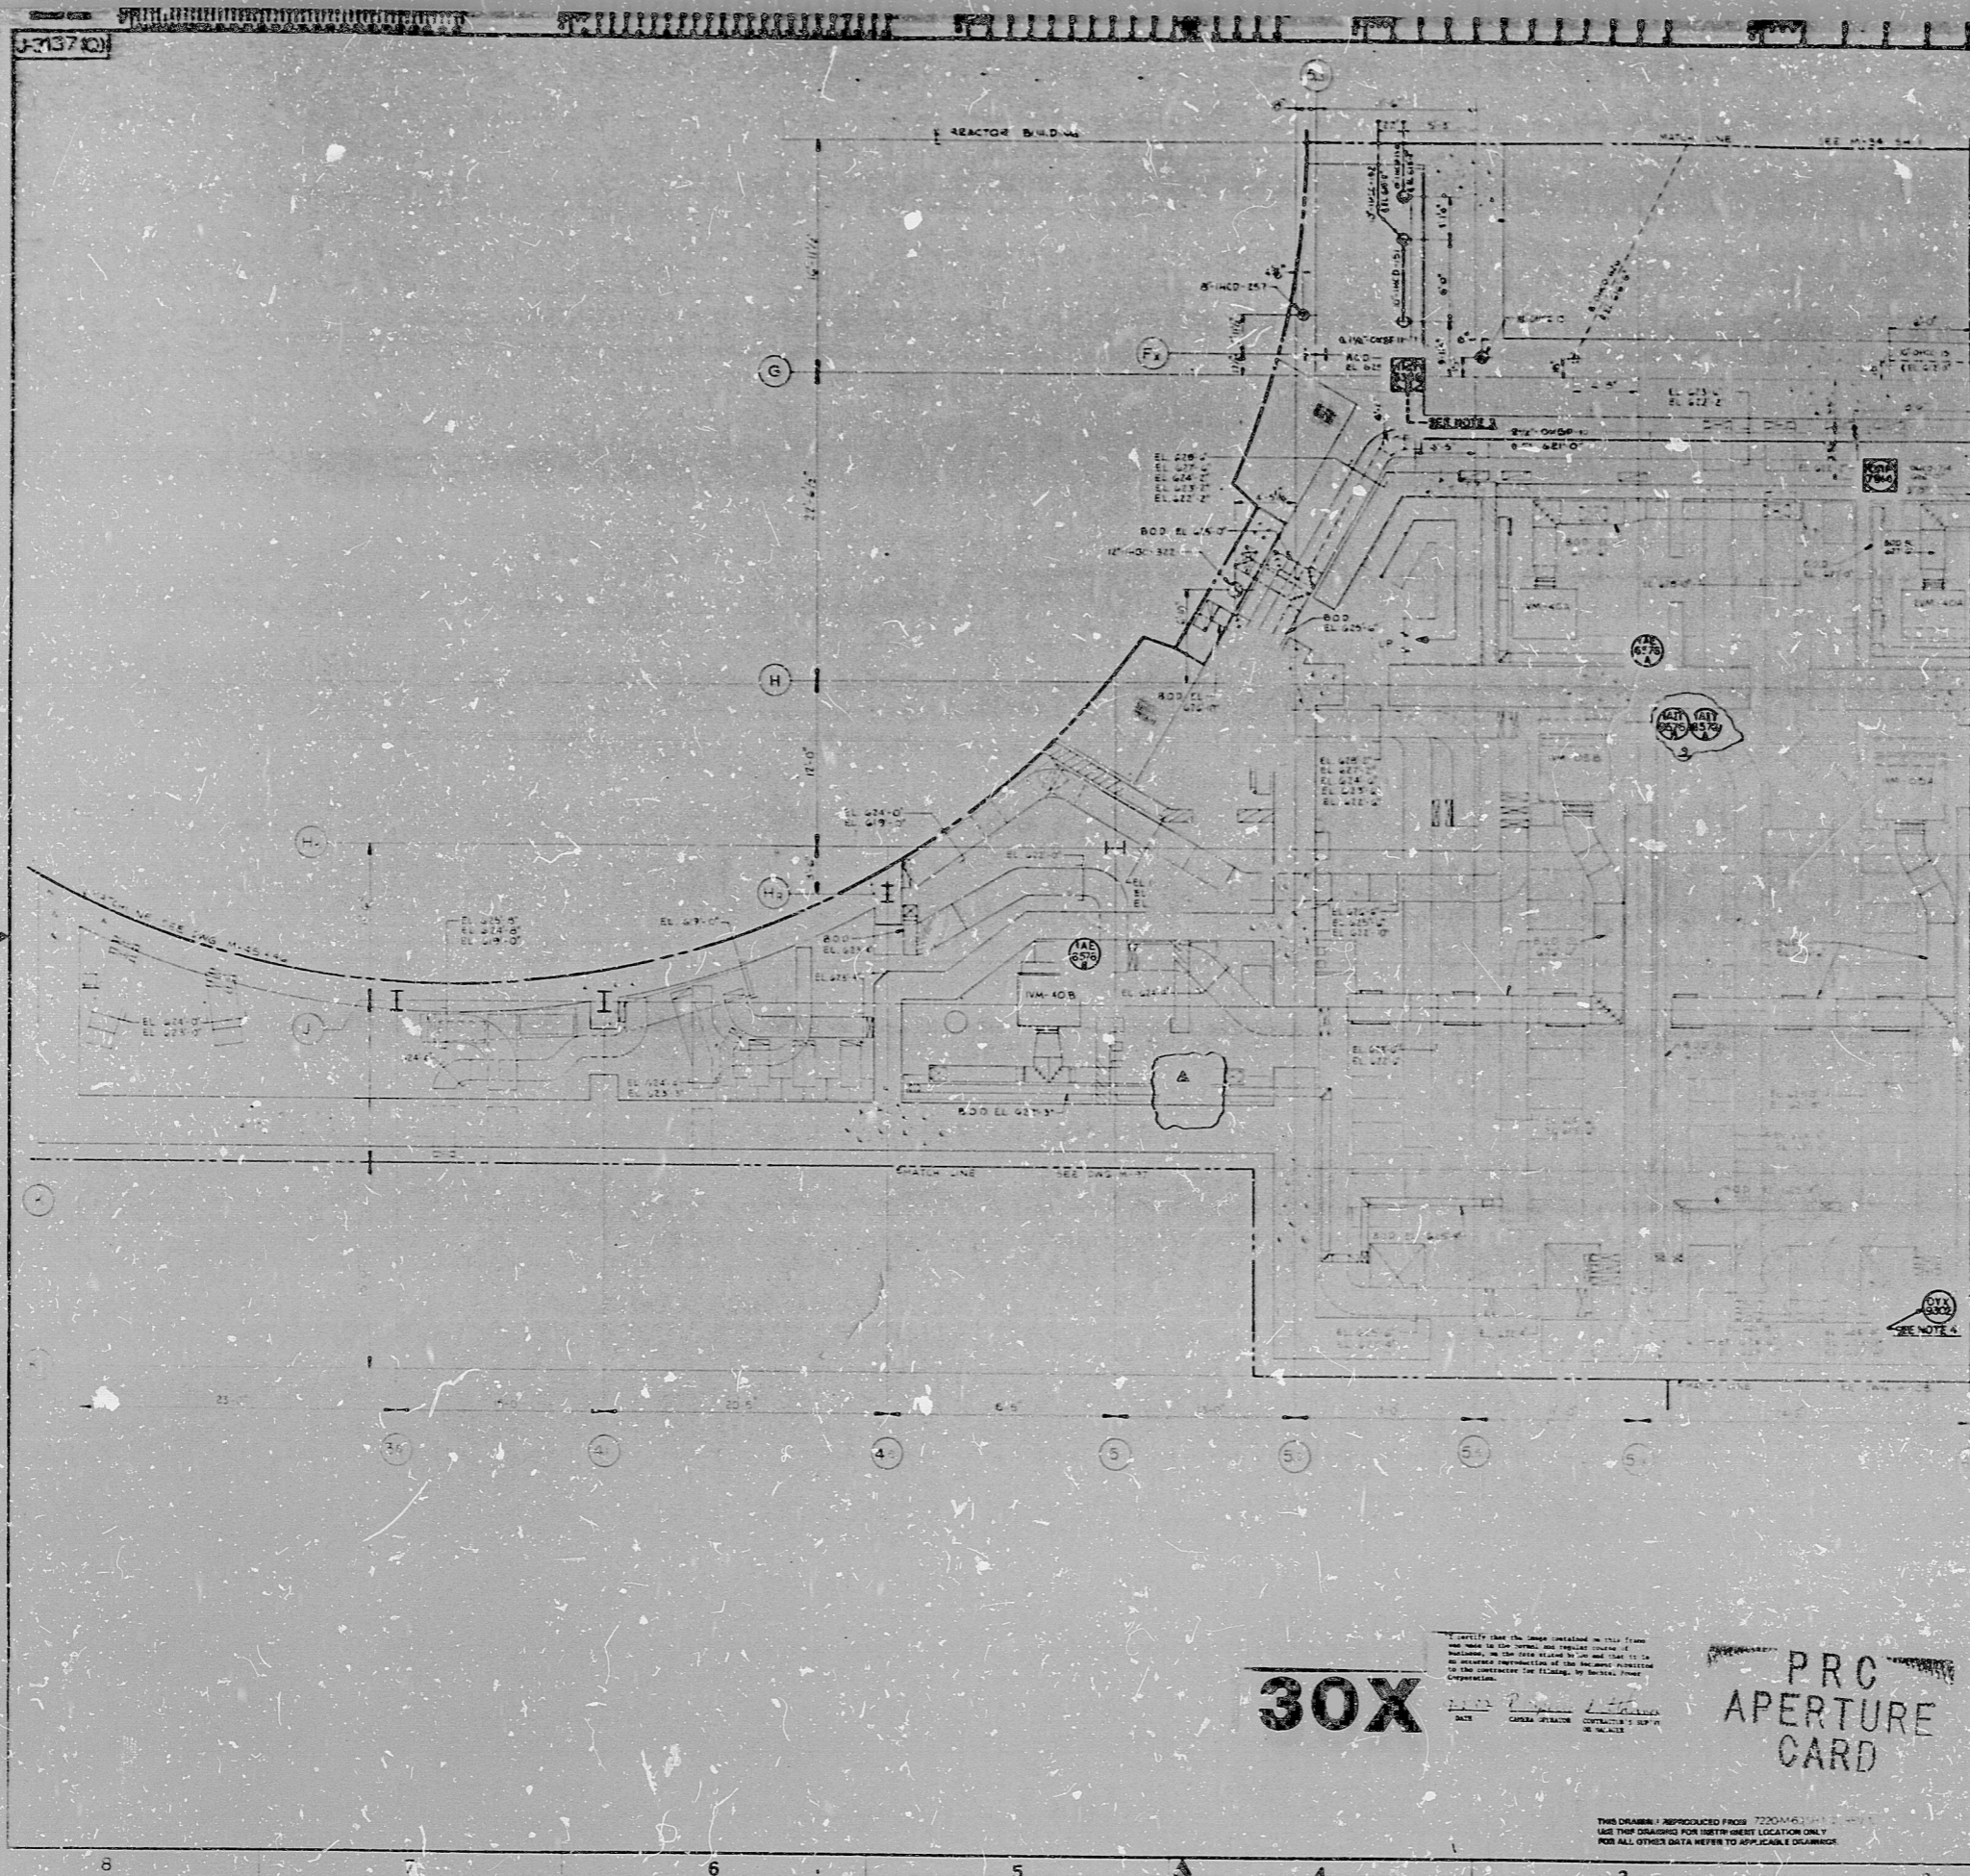


REVISIONS

NO. 1

DATE

BY

INSTRUMENT LOCATION DRAWING NOTES

1. SEE DWG 7220-J-3101 FOR ALL GENERAL NOTES.

2. DELETED

3. SIGNAL FROM DUCT MONITOR RE-5369B FOR "RE" LOCATION SEE DWG 7220-J-3127 EL. 650'.

4. REFER TO DWG 7220-J-314-3 FOR INSTALLATION DETAILS.

30X

PRC APERTURE CARD

NO.	DESCRIPTION	DATE	BY
1	REVISED AS INDICATED		
2	REVISED AS INDICATED		
3	REVISED AS INDICATED		
4	INCORPORATED FOR '80'S		
5	ADDED FOR INSTRUMENTATION		

BECHTEL

MIDLAND PLANT UNITS 1 & 2

CONSUMERS POWER COMPANY

INSTRUMENT LOCATION DRAWING

AREA 3

7220 J-3137 (C) 5

17"
11"
8.5"
8.5"
11"
17"

RIDS

8302040457

