


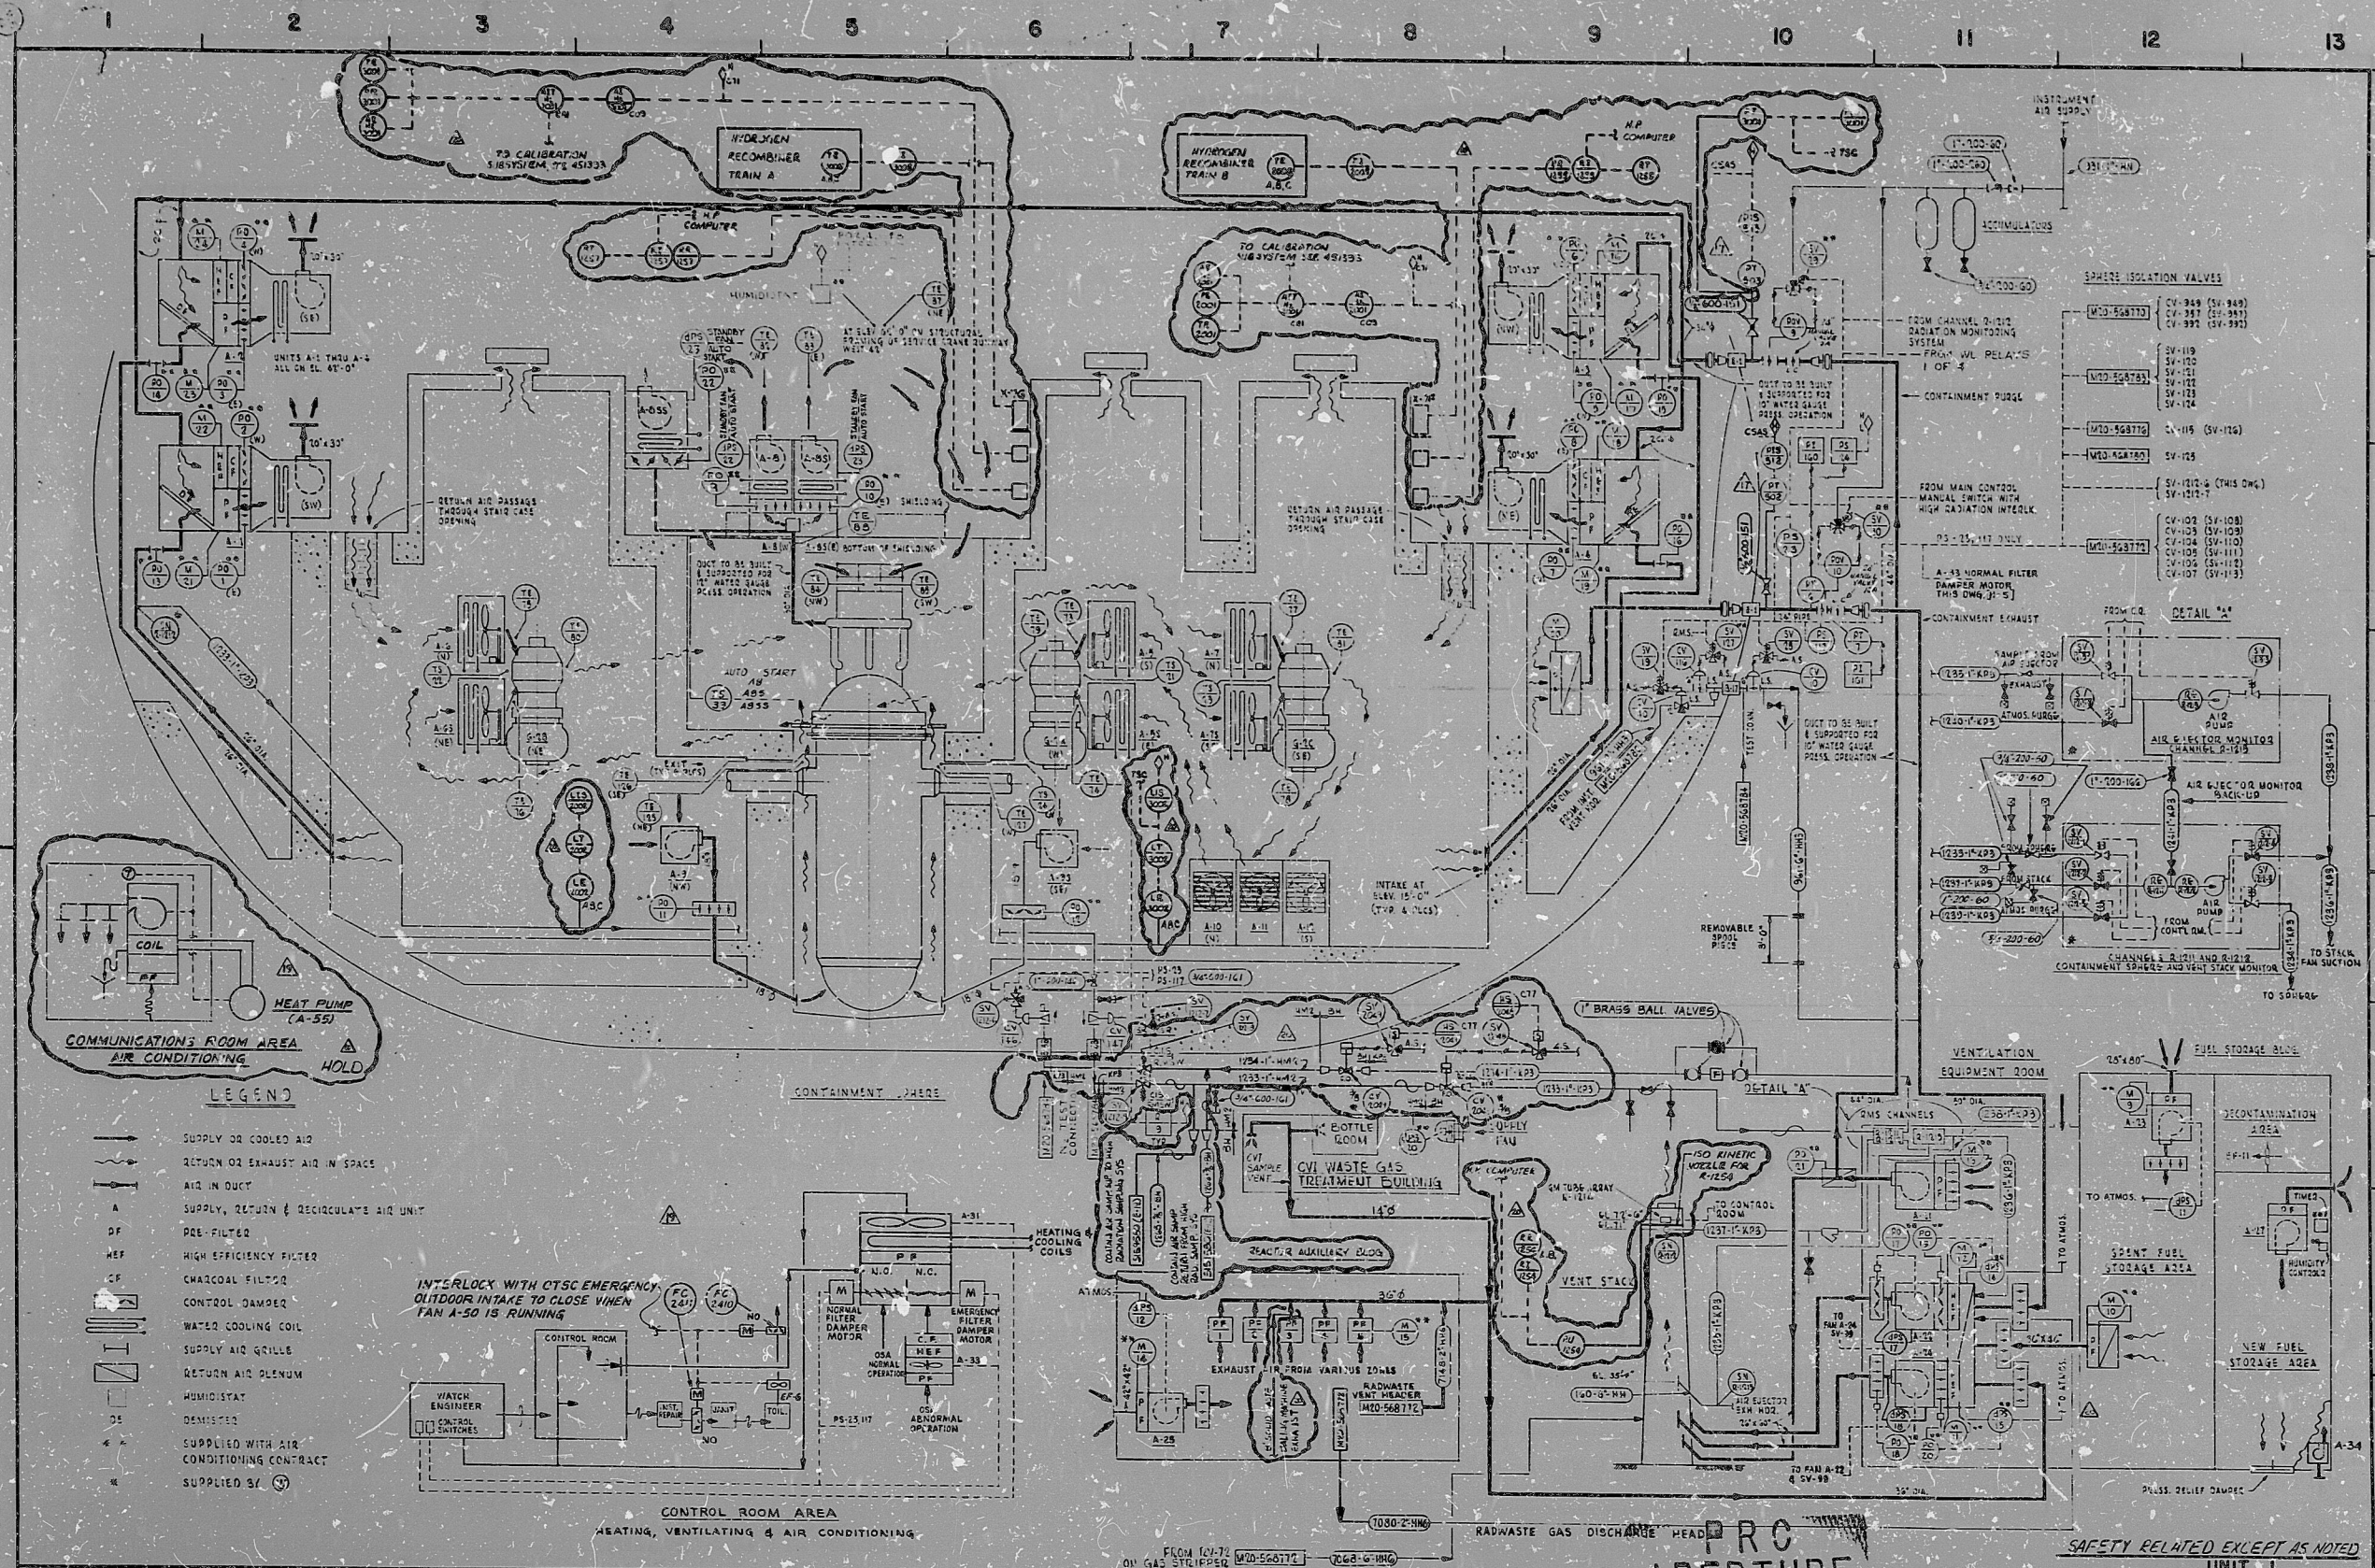

BECHTEL CORPORATION
ENGINEERS & CONSTRUCTORS
LOS ANGELES, CALIF.

DATE	APPROVED
3/24/66	9-28-66

NO.	REVISIONS	DATE	APPROVED	CHECKED	DATE	APPROVED	CHECKED
10	REVISED PER C.O. 14 & 15	11-9-61					
11	INCORPORATED C.O. 14 & 15 (LOW ELS. C.O. 14 & 15)	11-9-61					
12	REVISED PER C.O. 14 & 15	11-9-61					
13	RECORD REVISION	11-9-61					
14	INCORPORATED C.O. 14 & 15 AND C.O. 16	11-9-61					


568782-20

MICROFILMED FROM BEST AVAILABLE COPY

26X

RIDS

8302040518

