




PDR RIDS

8401130461

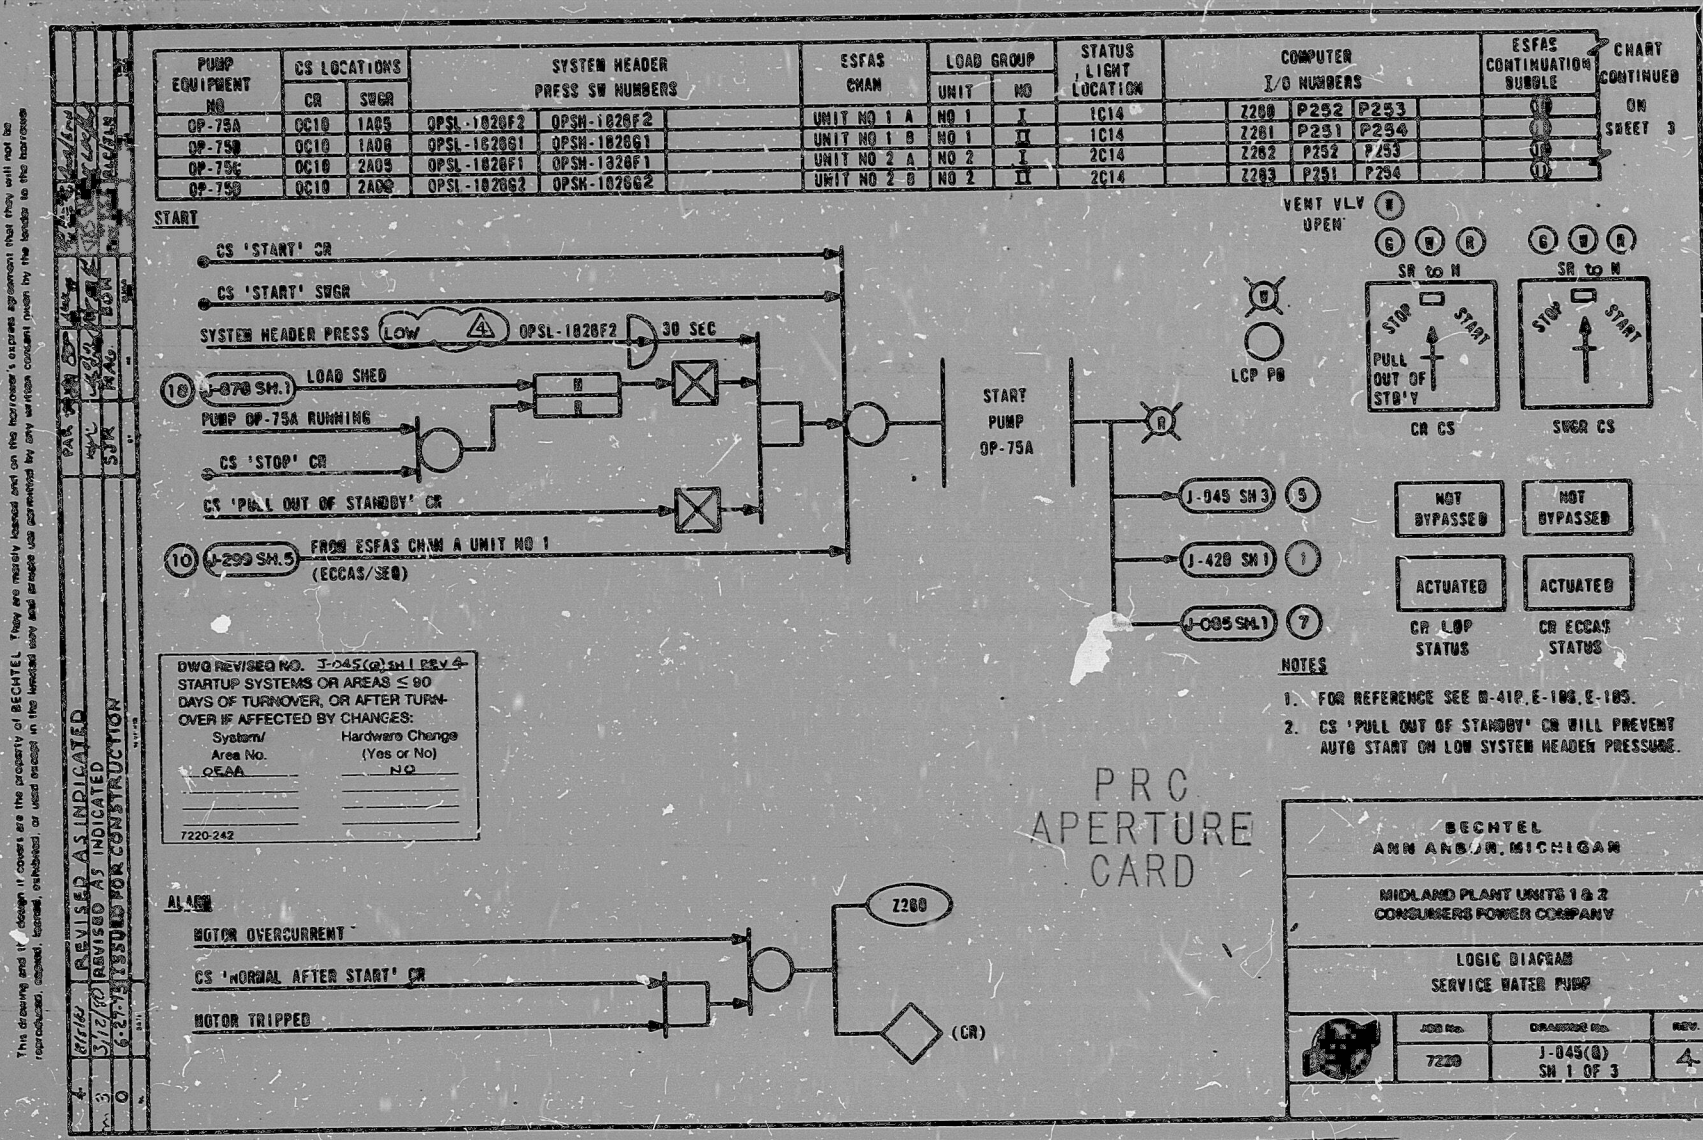