
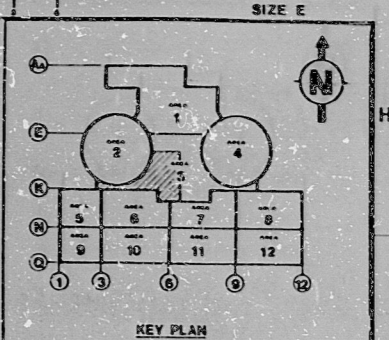


J-3139 (Q)

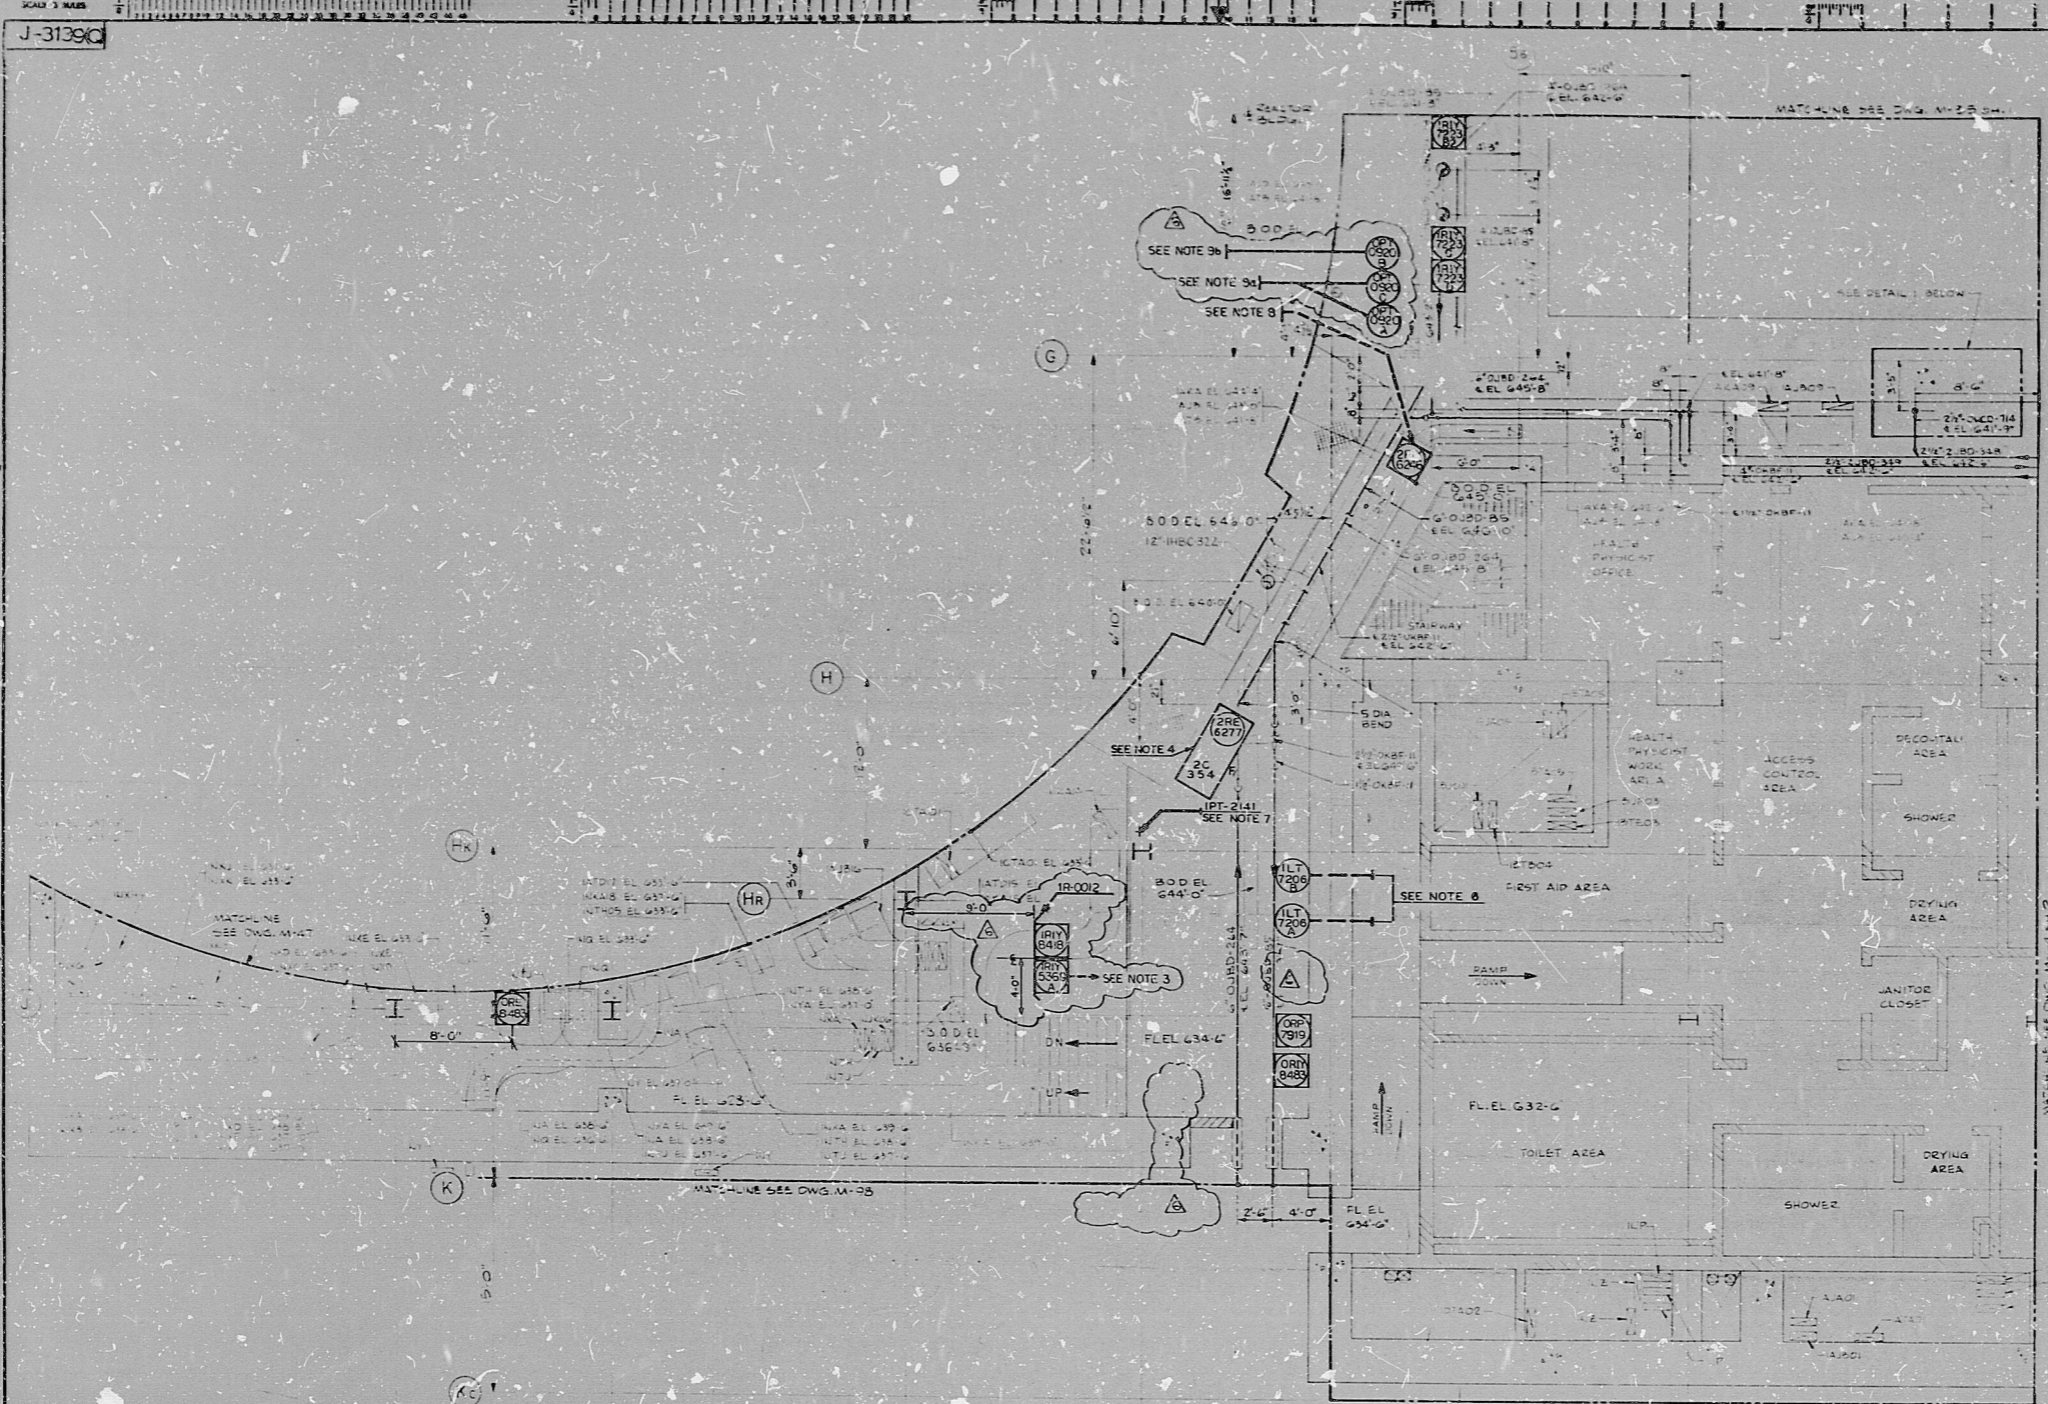



INSTRUMENT LOCATION DRAWING NOTES:
 1. SEE DRAWING 7220-J-3101(Q) FOR ALL GENERAL NOTES.
 2. DELETED
 3. SIGNAL FROM DUCT MONITOR (IR-5369A) FOR TAP LOCATION SEE DWG. 7220-J-3127 ELEVATION 658'-0"
 4. INSTRUMENT LOCATION ONLY. FOR TAP LOCATION REFER TO DWG. 7220-J-3149



BECHTEL

MIDLAND PLANT UNITS 1 & 2
 CONSUMERS POWER COMPANY

INSTRUMENT LOCATION DRAWING
 AREA 3
 PLAN OF FL 634'-6"

JOB NO.	DRAWING NO.	REV.
7220	J-3139 (Q)	6

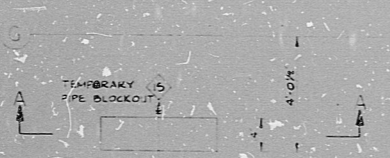

SECTION A-A
 SCALE: 1/2" = 1'-0"

PRC
 APERTURE
 CARD


THIS DRAWING REPRODUCED FROM 7220-J-64-SH1(Q) REV. 6
 USE THIS DRAWING FOR INSTRUMENT LOCATION ONLY.
 FOR ALL OTHER DATA REFER TO APPLICABLE DRAWINGS.

8.5"
 11"
 17"

8.5"
 11"
 17"

RID_s

8302040570

