


17"  
11"  
8.5"  
8.5"  
11"  
17"

17"  
11"  
8.5"  
8.5"  
11"  
17"

This drawing and the design it covers are the property of BECHTEL. They are hereby loaned and on the borrower's express agreement they may not be reproduced, copied, loaned, exhibited, or used except in the method and for the purpose specified by the borrower in his contract.

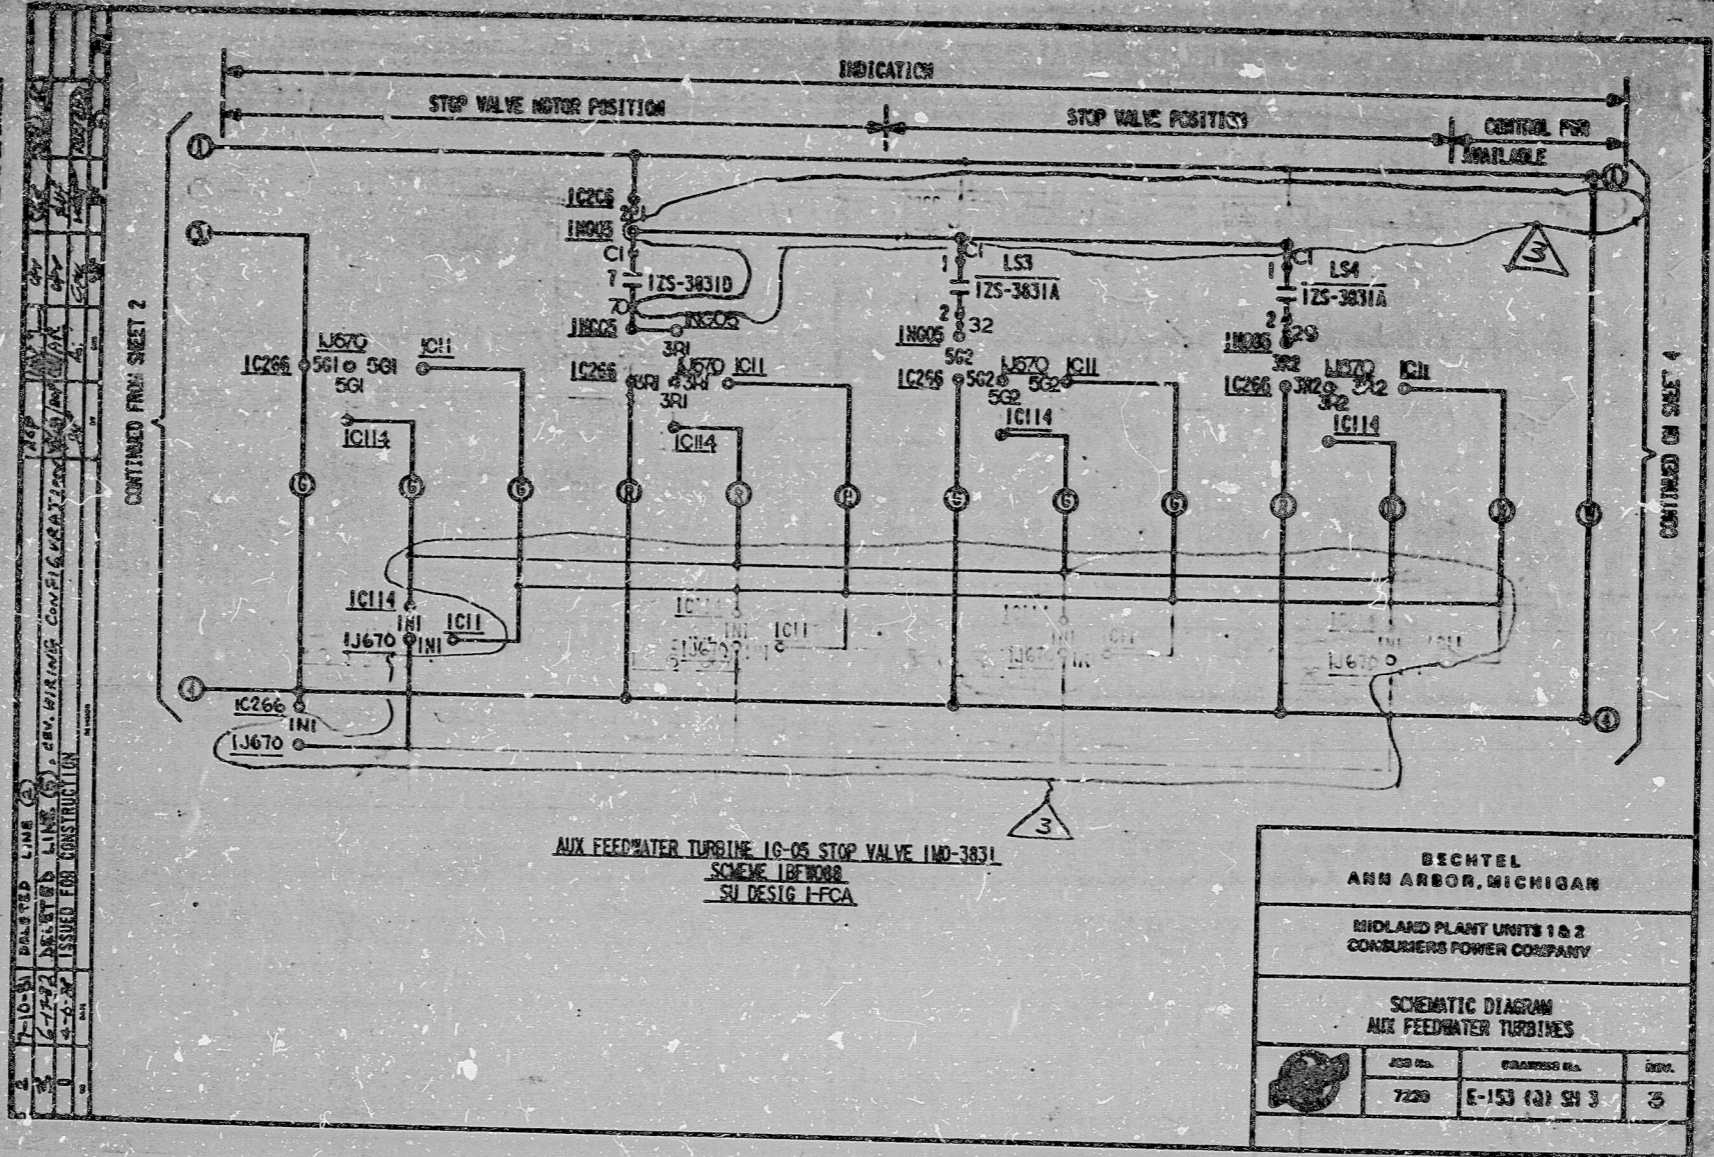

"I certify that the image contained on this frame was made in the normal and regular course of business, on the date stated below and that it is an accurate reproduction of the document submitted to the contractor for filing, by Bechtel Power Corporation.  
 DATE: 6-21-82  
 CAMERA OPERATOR: M. C. Sisson  
 CONTRACTOR'S SUPERVISOR OR MANAGER: J. C. Sisson

**16X**

PRC  
 APERTURE  
 CARD

RIDS

8302040602

