



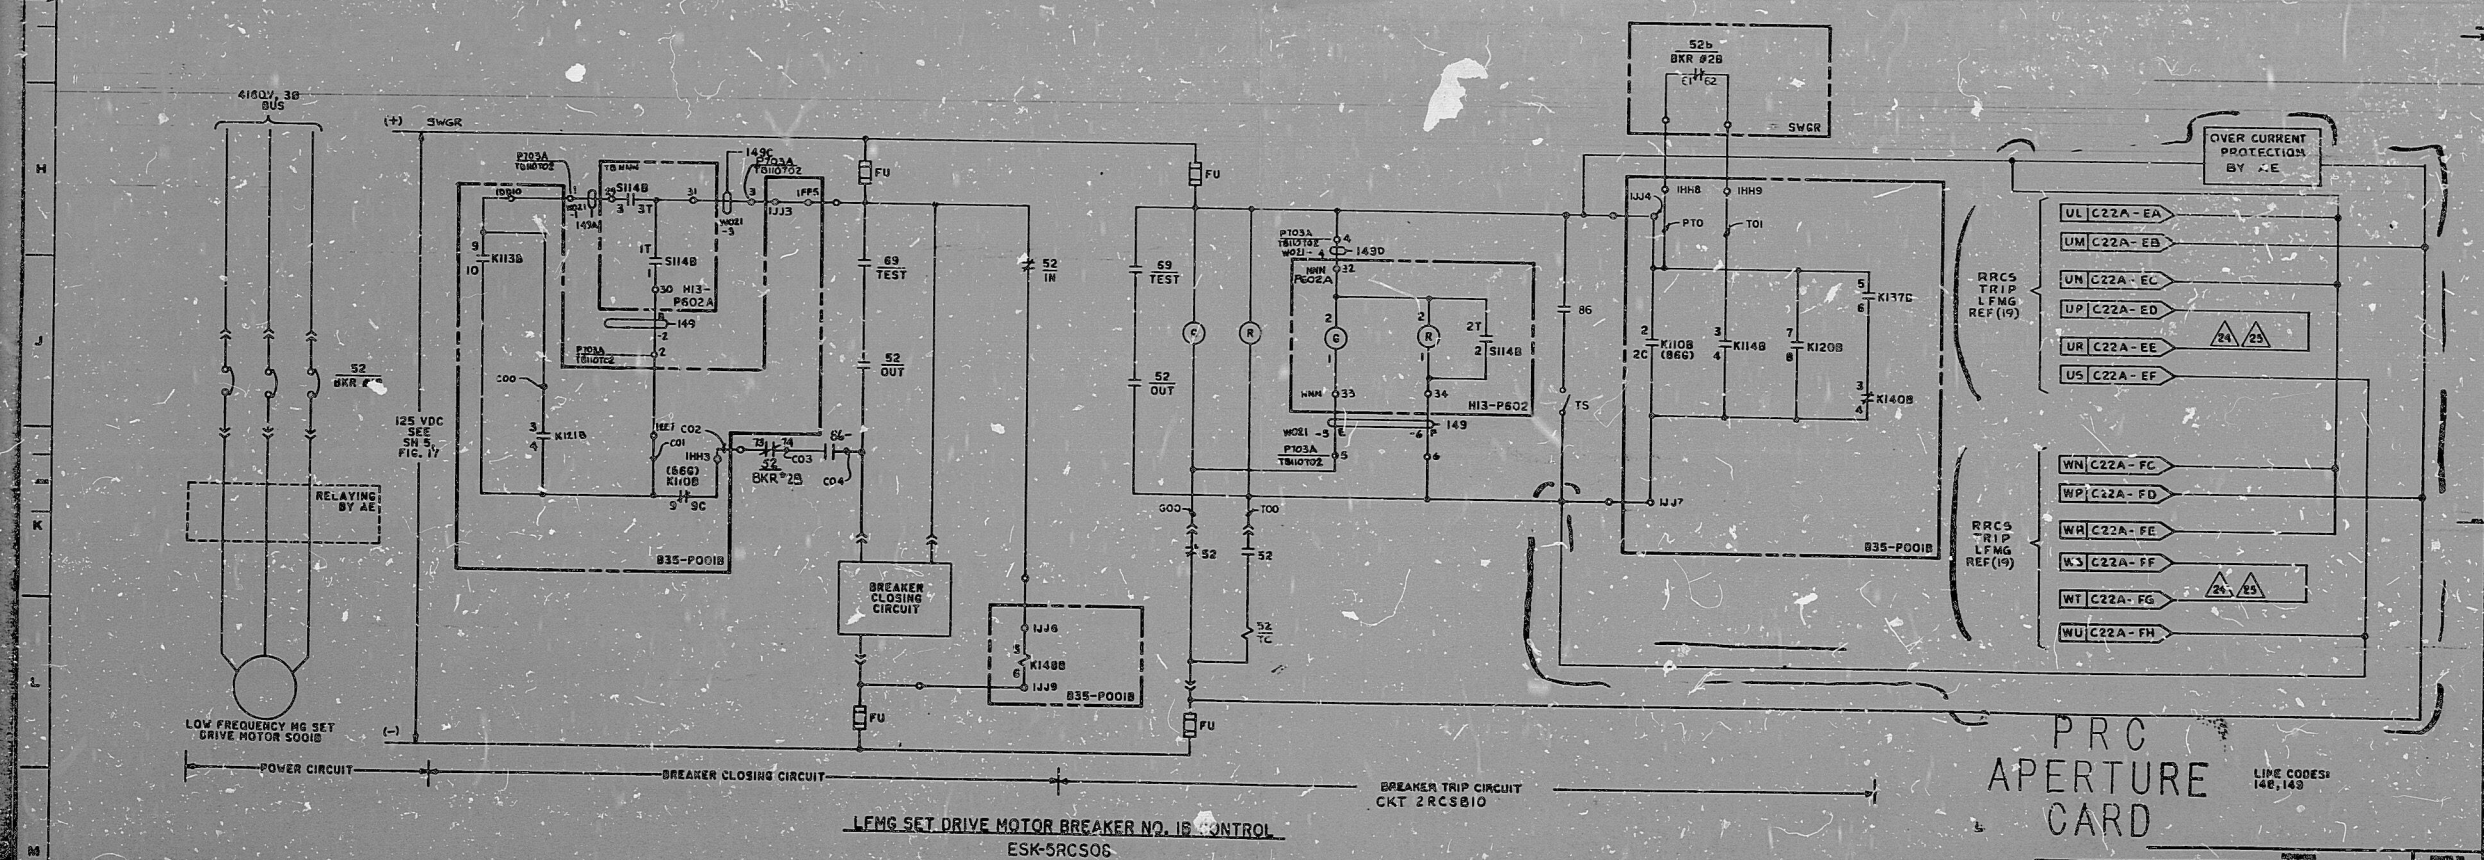

4	11/11/57	3	11/11/57	2	11/11/57	1	11/11/57

PDR RID'S

8401160443

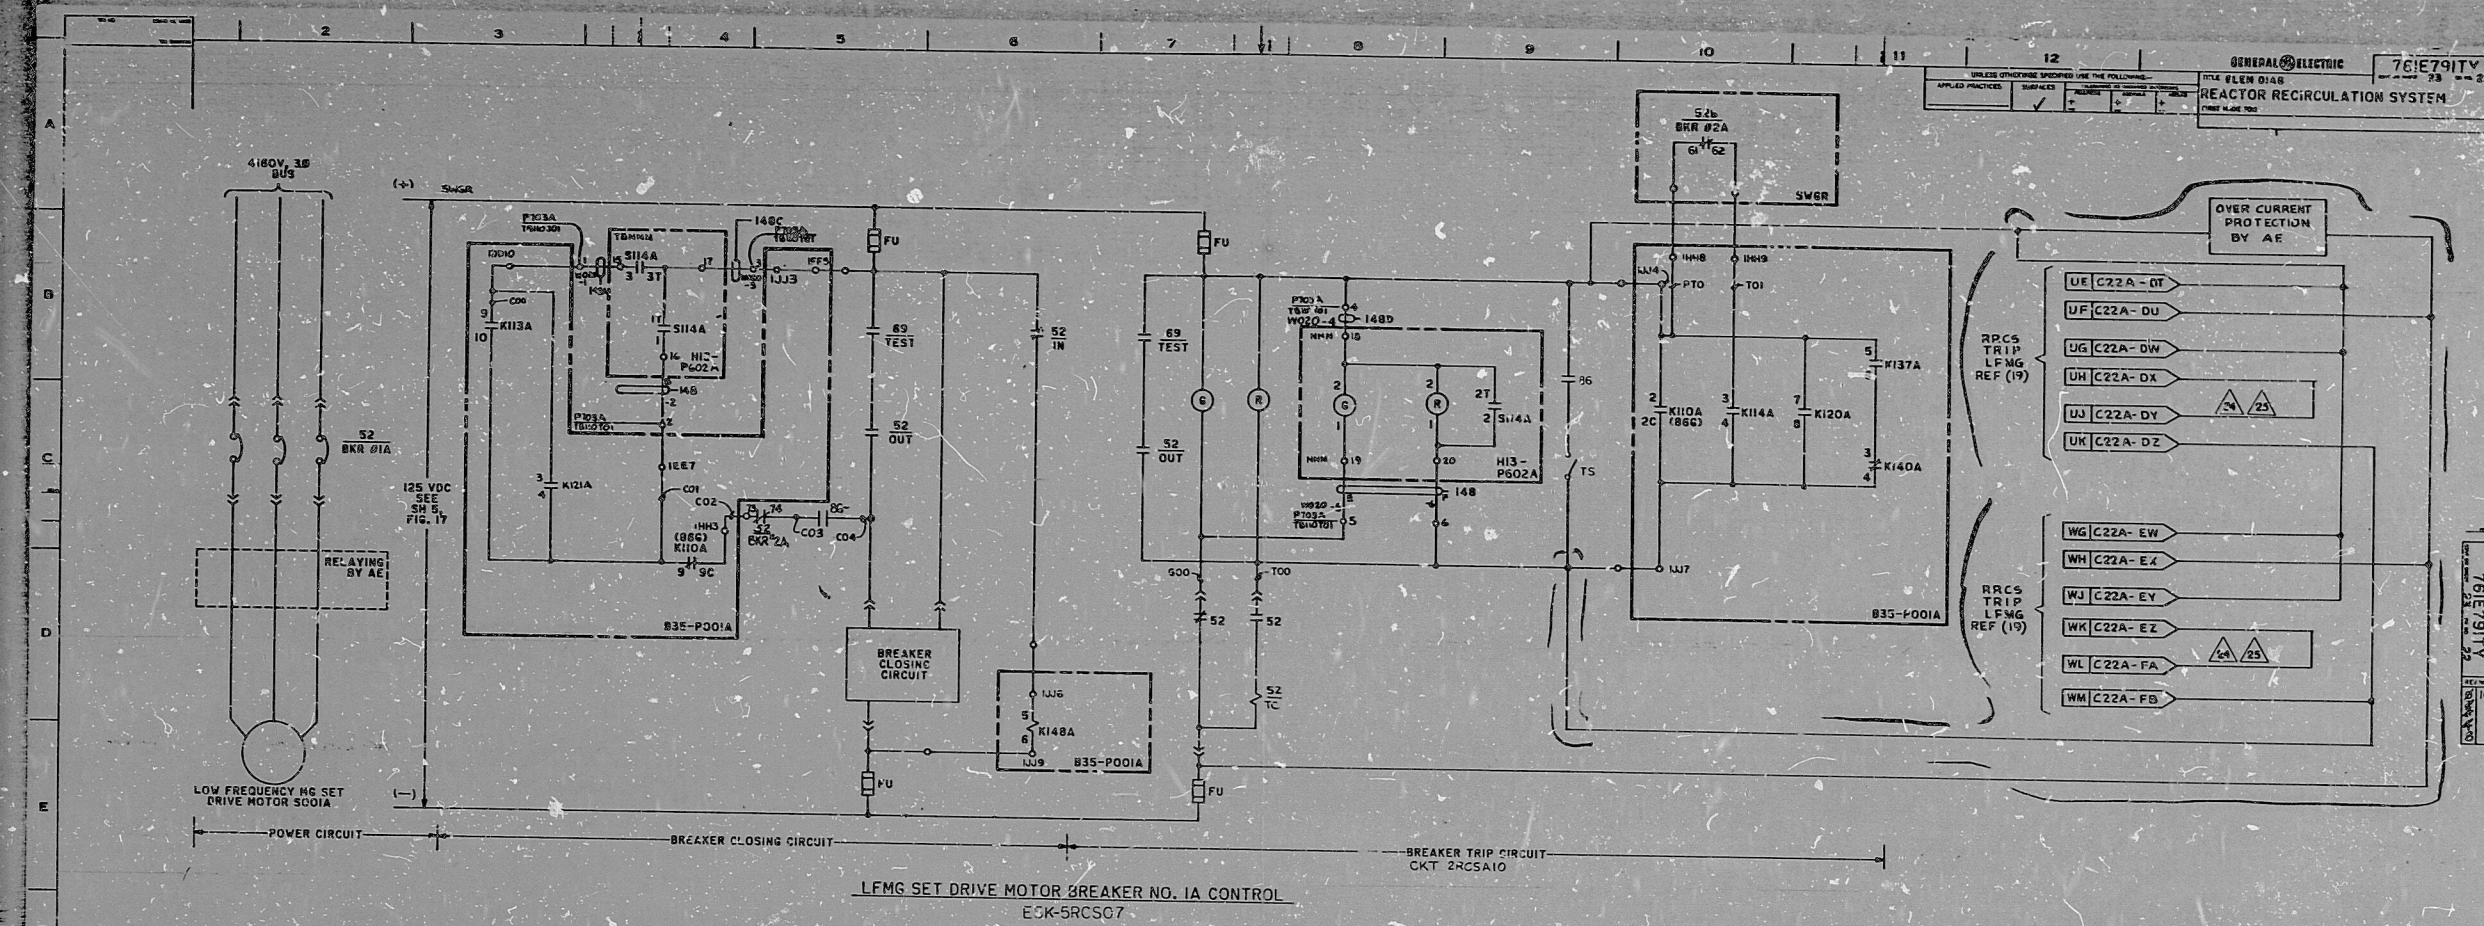