

17"

11"

8.5"

8.5"

11"

17"

17"


11"

8.5"

8.5"

11"

17"

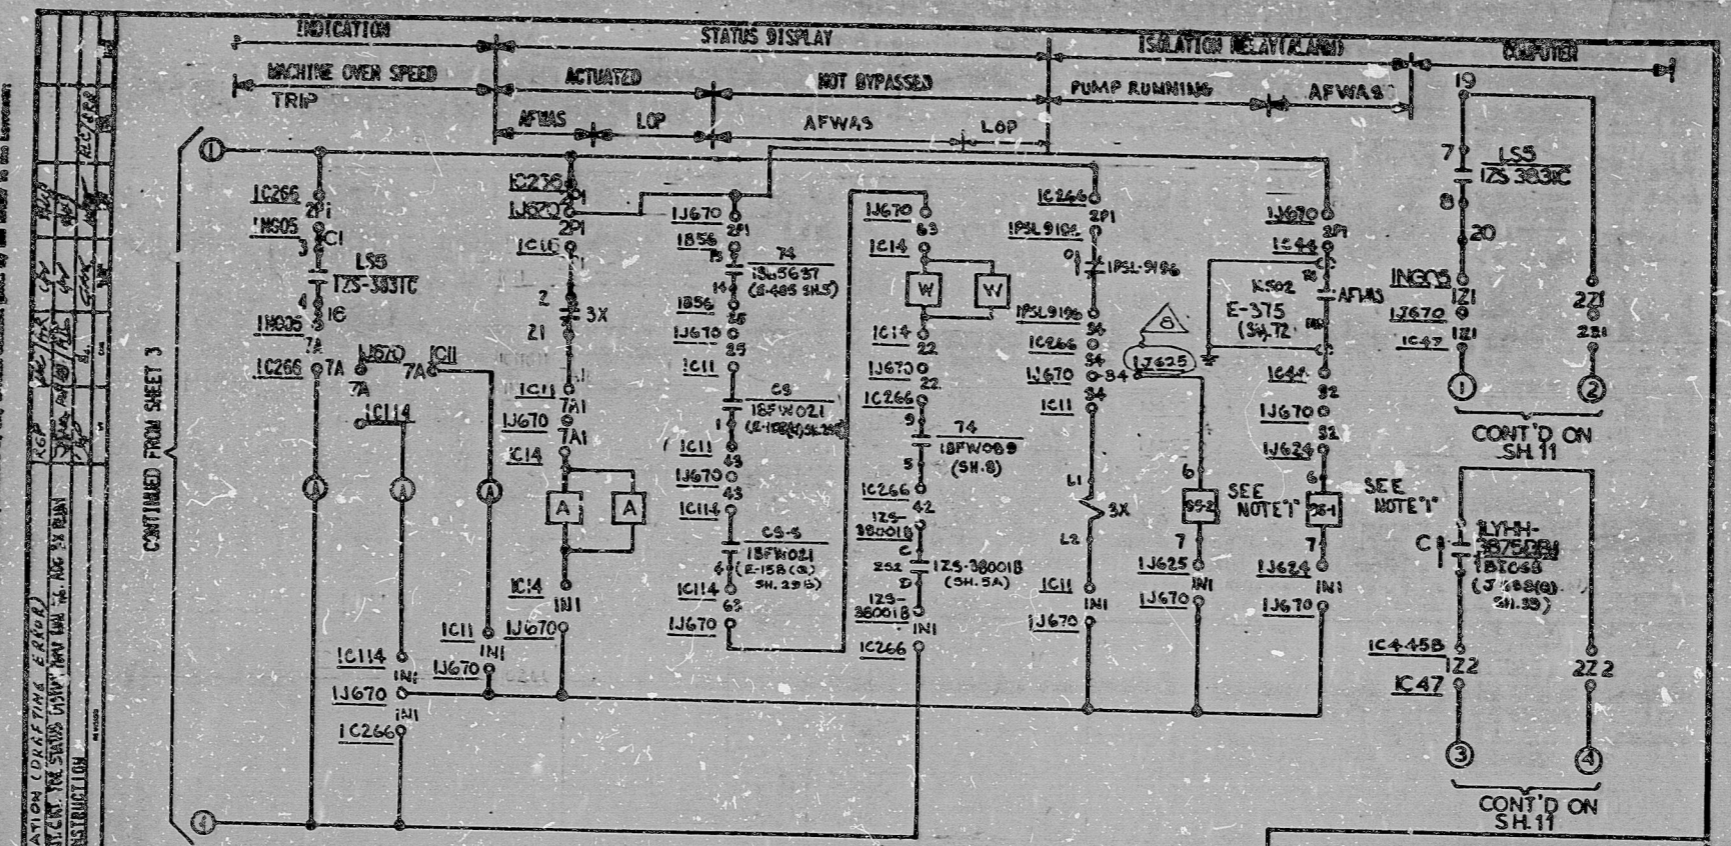

This drawing and the design it covers are the property of BECHTEL. They are strictly loaned and are to be used only for the purposes intended. No part of this drawing is to be reproduced, stored, loaned, established, or used except in the limited way and for the limited use permitted by any written consent given by the holder of the copyright.


SU DESIG I-PCA

**DEVICE TABLE:**  
 AFWAS - AUX FEEDWATER ACTUATION SIGNAL  
 95-1 - LOCAL DIGITAL ISOLATION RELAY  
 95-2 - LOCAL DIGITAL ISOLATION RELAY  
 IPSL-9196: TURBINE DRIVEN PUMP CONTROL OIL PRESSURE SW. (CONTACT CLOSURES ON LOW PRESSURE WHEN PUMP IS NOT RUNNING)  
 3X: AUX RELAY ITE TYPE. (CAT. # J13PZ512)  
 125-38001B: MAN. RECIRC. VALVE POS. SWITCH

**NOTE:**  
 1. ISOLATION & SEPARATION MUST BE MAINTAINED BETWEEN LOCAL ISOLATION RELAY 95-1 & 95-2 INPUT (CHAM B) AND OUTPUT CONTACTS (NON-CLASS 1E)

BECHTEL  
ANN ARBOR, MICHIGAN

INDLAND PLANT UNITS 1 & 2  
CONSUMERS POWER COMPANY

SCHEMATIC DIAGRAM  
AUX FEEDWATER TURBINES

REV.	DESCRIPTION	DATE
7220	E-153 (0) SH 4	8

"I certify that the image contained on this frame was made in the normal and regular course of business, on the date stated below and that it is an accurate reproduction of the document submitted to the contractor for filming, by Bechtel Power Corporation.

7-2-82  
DATE  
M. Casco  
CAMERA OPERATOR  
J. Callahan  
CONTRACTOR'S SUPERVISOR OR MANAGER

16X

PRC APERTURE CARD

RIDS

8302040606

