


17"
11"
8.5"
8.5"
11"
17"

17"
11"
8.5"
8.5"
11"
17"

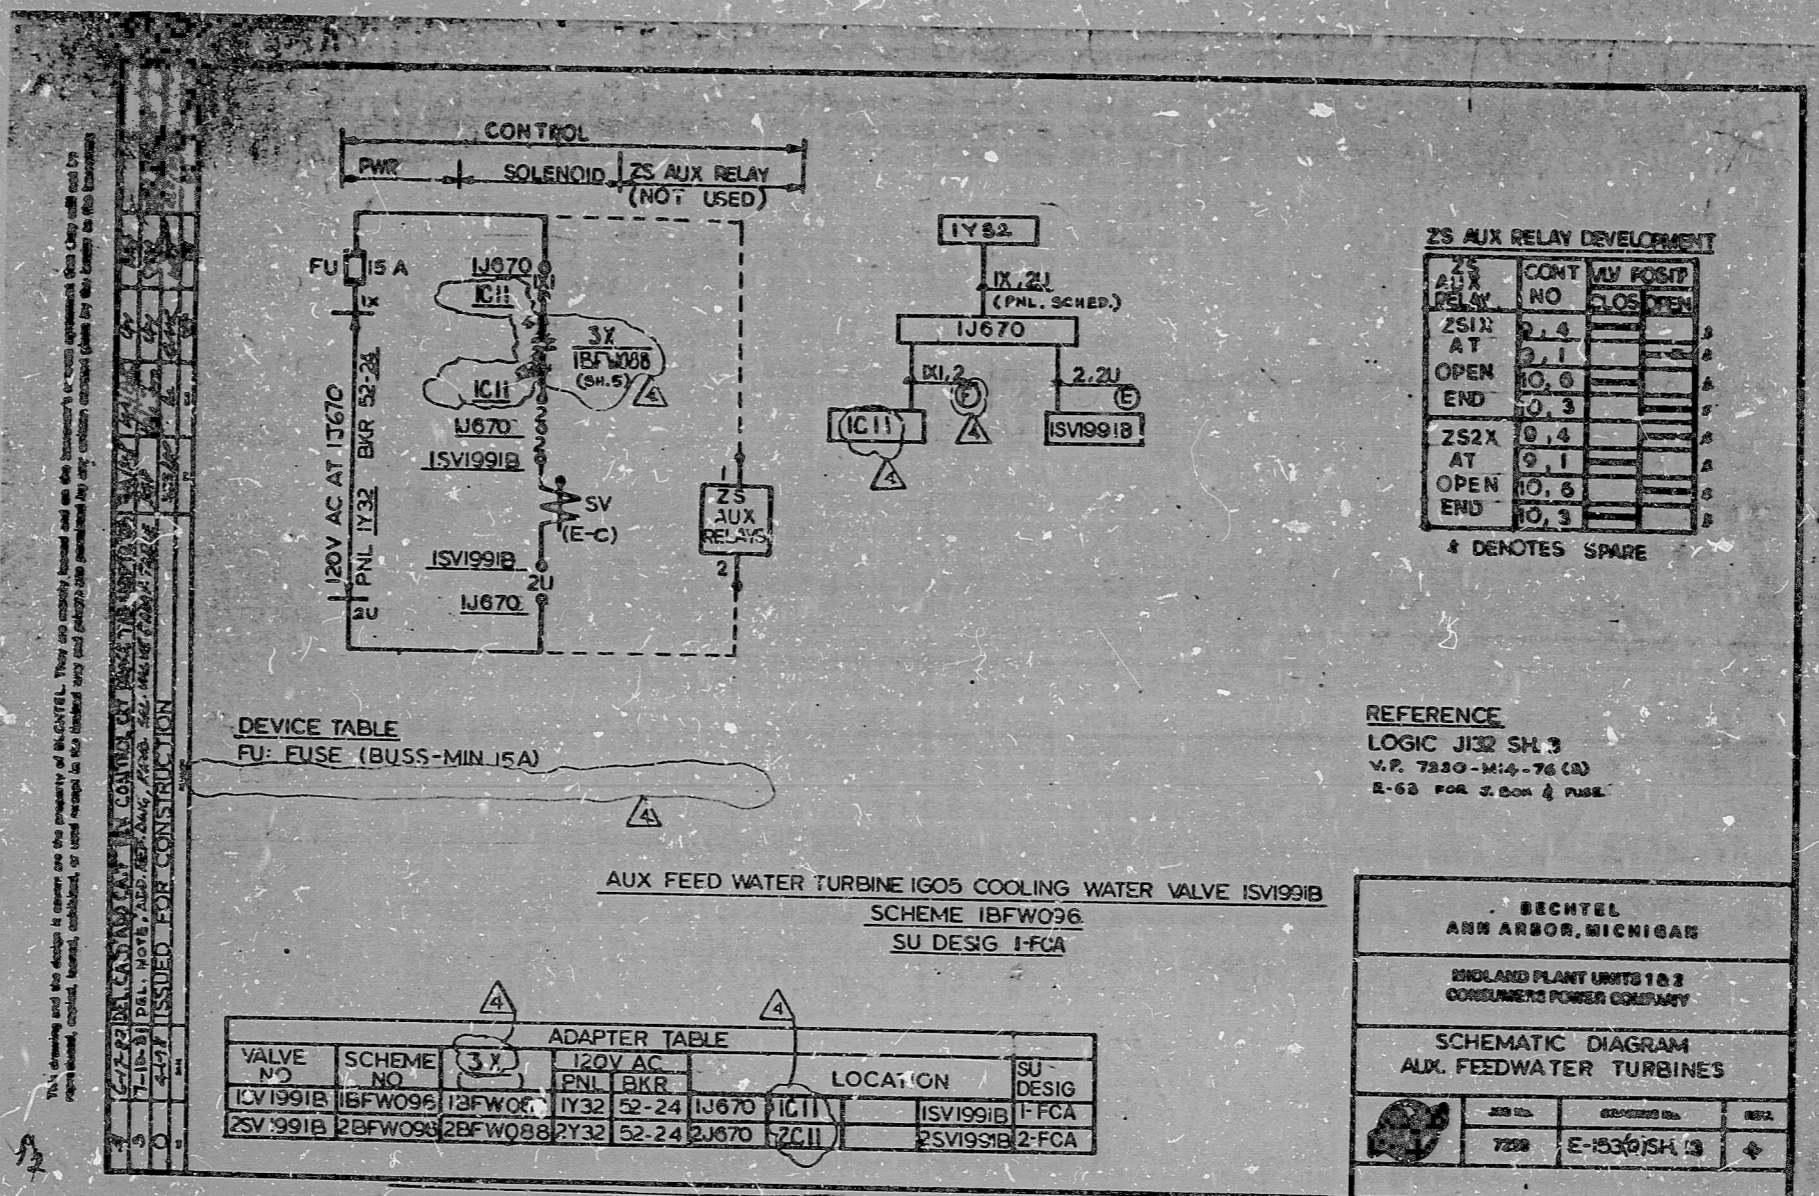

ADAPTER TABLE

VALVE NO	SCHEME NO	120V AC		LOCATION	SU DESIG
		PNL	BKR		
ICV1991B	1BFW096	1Y32	52-24	1J670 IC11	1-FCA
2SV1991B	2BFW098	2Y32	52-24	2J670 2C11	2-FCA

"I certify that the info contained on this frame was made in the normal and regular course of business, on the date stated below and that it is an accurate reproduction of the document submitted to the contractor for filing, by Bechtel Power Corporation."

6-21-82 DATE
M. S. ... CAMERA OPERATOR
J. ... CONTRACTOR'S SUP' VR. OR MANAGER

16X

PRC
APERTURE
CARD

RIDS

8302040613

