


This drawing and the design it covers are the property of BECHTEL. They are hereby loaned out on the borrower's express agreement that they will not be reproduced, copied, loaned, exhibited, or used except in the limited way and for the limited amount given by the letter to the borrower.

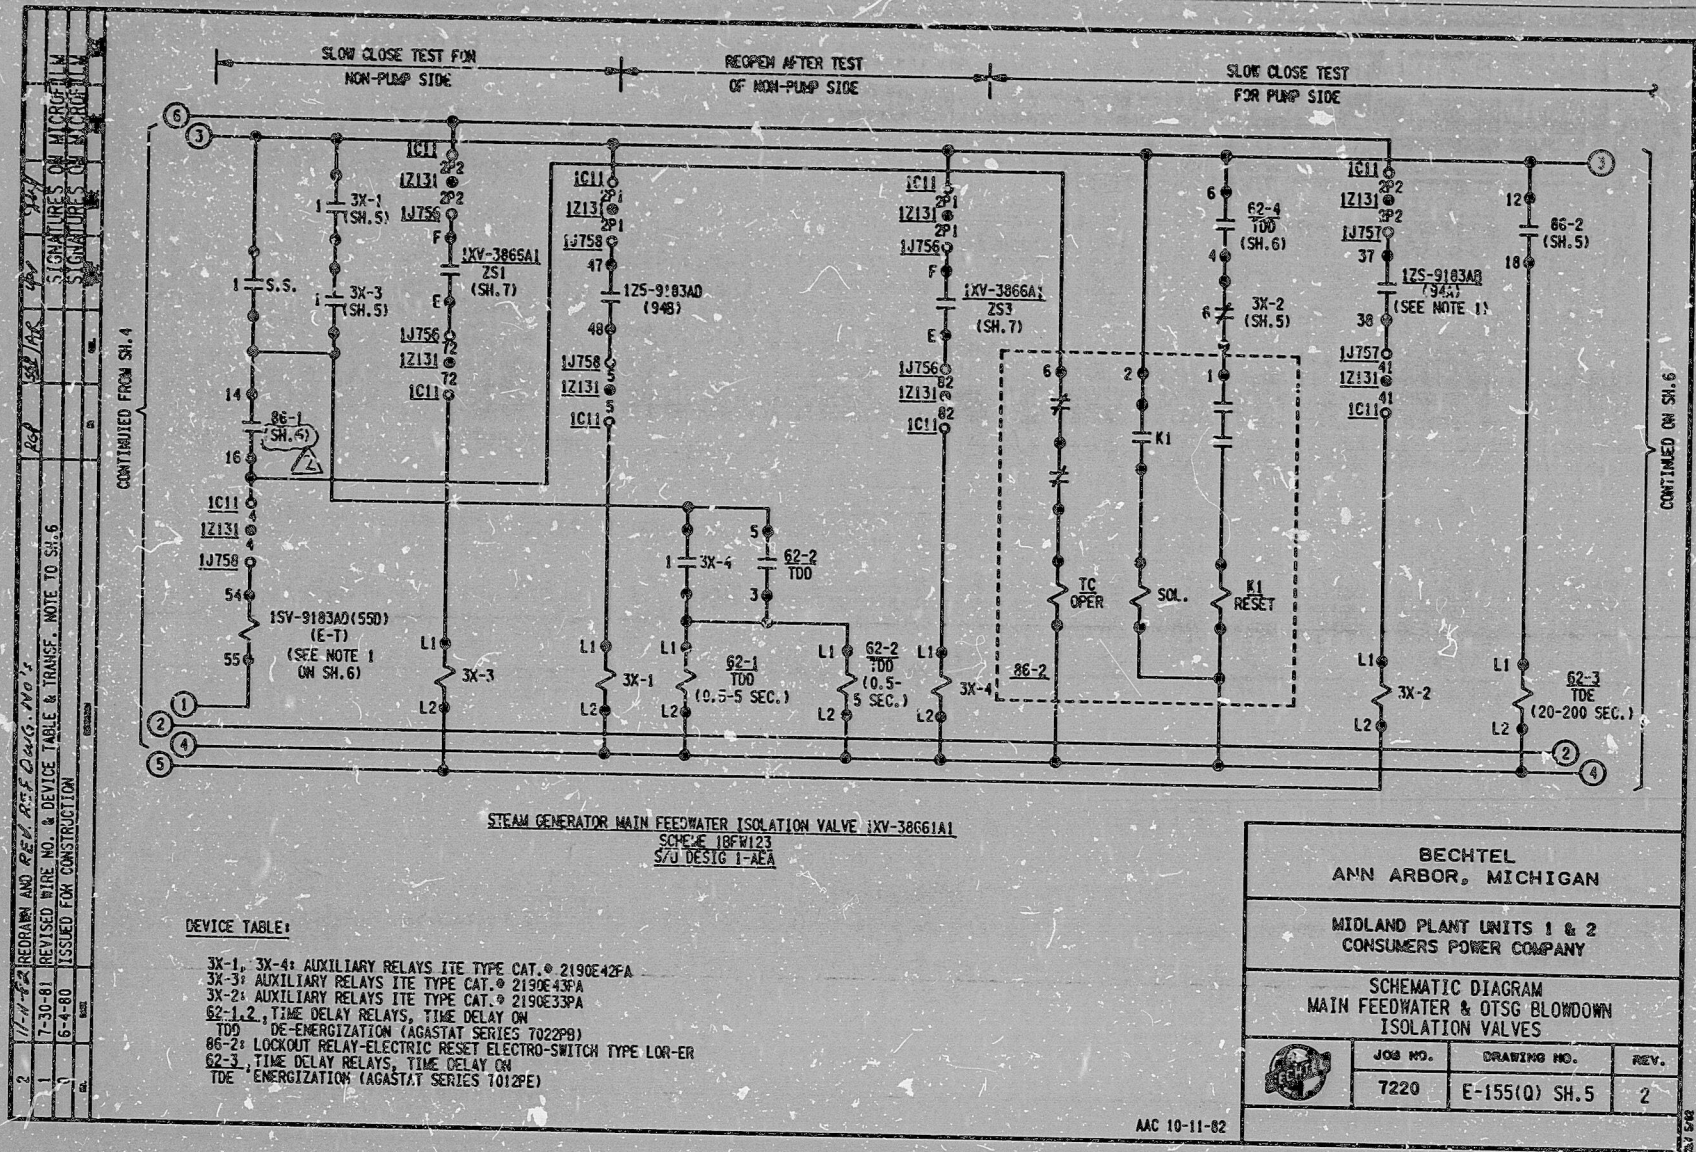

DEVICE TABLE:

3X-1, 3X-4	AUXILIARY RELAYS ITE TYPE CAT. # 2190E42FA
3X-3	AUXILIARY RELAYS ITE TYPE CAT. # 2190E43FA
3X-2	AUXILIARY RELAYS ITE TYPE CAT. # 2190E33PA
62-1, 2	TIME DELAY RELAYS, TIME DELAY ON
TDD	DE-ENERGIZATION (AGASTAT SERIES 7022PB)
86-2	LOCKOUT RELAY-ELECTRIC RESET ELECTRO-SWITCH TYPE LOR-ER
62-3	TIME DELAY RELAYS, TIME DELAY ON
TDE	ENERGIZATION (AGASTAT SERIES 1012PE)

BECHTEL
ANN ARBOR, MICHIGAN

MIDLAND PLANT UNITS 1 & 2
CONSUMERS POWER COMPANY

SCHEMATIC DIAGRAM
MAIN FEEDWATER & DTSG BLOWDOWN
ISOLATION VALVES

JOB NO.	DRAWING NO.	REV.
7220	E-155(0) SH. 5	2

I certify that the image contained on this frame was made in the normal and regular course of business, on the date stated below and that it is an accurate reproduction of the document submitted to the contractor for filing, by Bechtel Power Corporation.

11-15-82 DATE
C. Clarke CAMERA OPERATOR
M. Thomas CONTRACTOR'S SUPERVISOR OR MANAGER

16X

PRO
APERTURE
CARD

RIDS

8302070030

