


This drawing and the design it covers are the property of BECHTEL. They are hereby loaned and an licensee's express agreement that they will not be reproduced, copied, loaned, leased, or used except in the limited way and for the limited purpose intended by the licensor is hereby acknowledged.

NO.	REVISION	DATE	BY	CHKD.	DESCRIPTION
1	7-30-81				REVISED DEVICE TABLE ADDS NOTE FROM SH. 5
2	11-15-82				REDRAWN & REVISED LOCKOUT RELAY TABLE NOTE REF. ISSUED FOR CONSTRUCTION
0	6-4-80				ISSUED FOR CONSTRUCTION

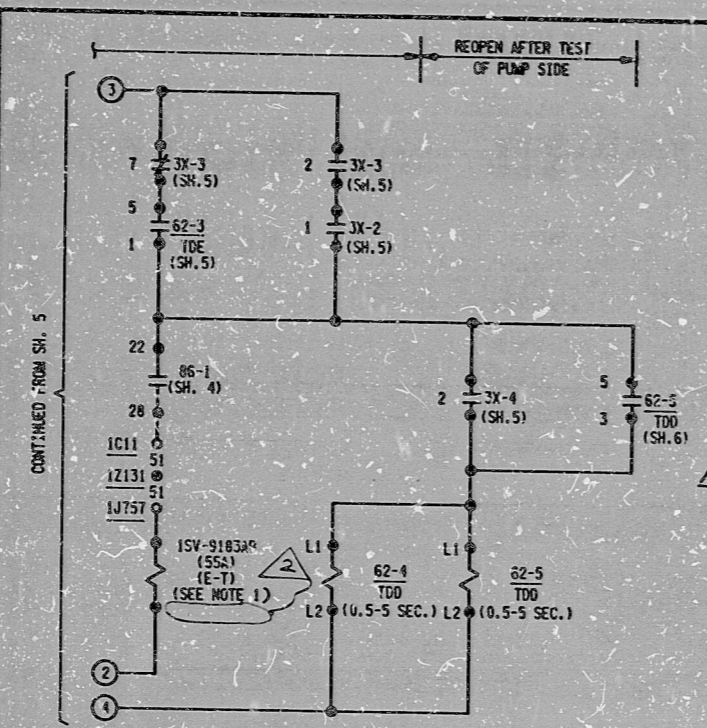

CONTACT	FUNCTION	REF. DRG.
11-13	SPARE	
12-10	CONTROL OPEN/CLOSE	THIS DRG SH. 4
15-17	SPARE	
16-14	SLOW CONT. TEST FOR NON PUMP SIDE	THIS DRG SH. 5
21-23	SPARE	
22-28	SLOW CLOSE TEST FOR PUMP SIDE	THIS DRG SH. 6
25-27	ISOLATION CIRCUIT	SH. 11
26-24	ISOLATION CIRCUIT	SH. 11
31-33	SPARE	
32-38	SPARE	
37-37	SPARE	
36-34	SPARE	

CONTACT	FUNCTION	REF. DRG.
11-13	SPARE	
12-18	SLOW CLOSE TEST FOR PUMP SIDE	THIS DRG SH. 5
15-17	SPARE	
16-14	SPARE	
21-25	SPARE	
22-28	SPARE	
25-27	SPARE	
26-24	SPARE	
31-33	SPARE	
32-38	SPARE	
35-37	SPARE	
36-34	SPARE	

NOTE:  
1. NUMBERS SHOWN IN PARENTHESES ARE VENDOR DESIGNATIONS.

STEAM GENERATOR MAIN FEEDWATER ISOLATION VALVE (IXV-386EA)  
SCHEME 18FW123  
SU DESIG. 1-AEA

DEVICE TABLE:

62-4, 5	TIME DELAY RELAYS, TIME DELAY ON DE-ENERGIZATION (AGASTAT SERIES 7022P0)
TOD	

BECHTEL  
ANN ARBOR, MICHIGAN

MIDLAND PLANT UNITS 1 & 2  
CONSUMERS POWER COMPANY

SCHEMATIC DIAGRAM  
MAIN FW & OTSG BLOWDOWN  
ISOLATION VALVES

JOB NO.	DRAWING NO.	REV.
7220	E-155 SH. 6 (0)	2

AAC 10-19-82

I certify that the image contained on this frame was made in the normal and regular course of business, on the date stated below and that it is an accurate reproduction of the document submitted to me by contractor for filing, by Bechtel Power Corporation.

11-15-82 DATE  
C. Martin OPERATOR  
M. Thomas CONTRACTOR'S SUP'VE OR MAN'GER

16X

PRC  
APERTURE  
CARD

RIDS

8302070932

