


17"
11"
8.5"
8.5"
11"
17"

17"
11"
8.5"
8.5"
11"
17"

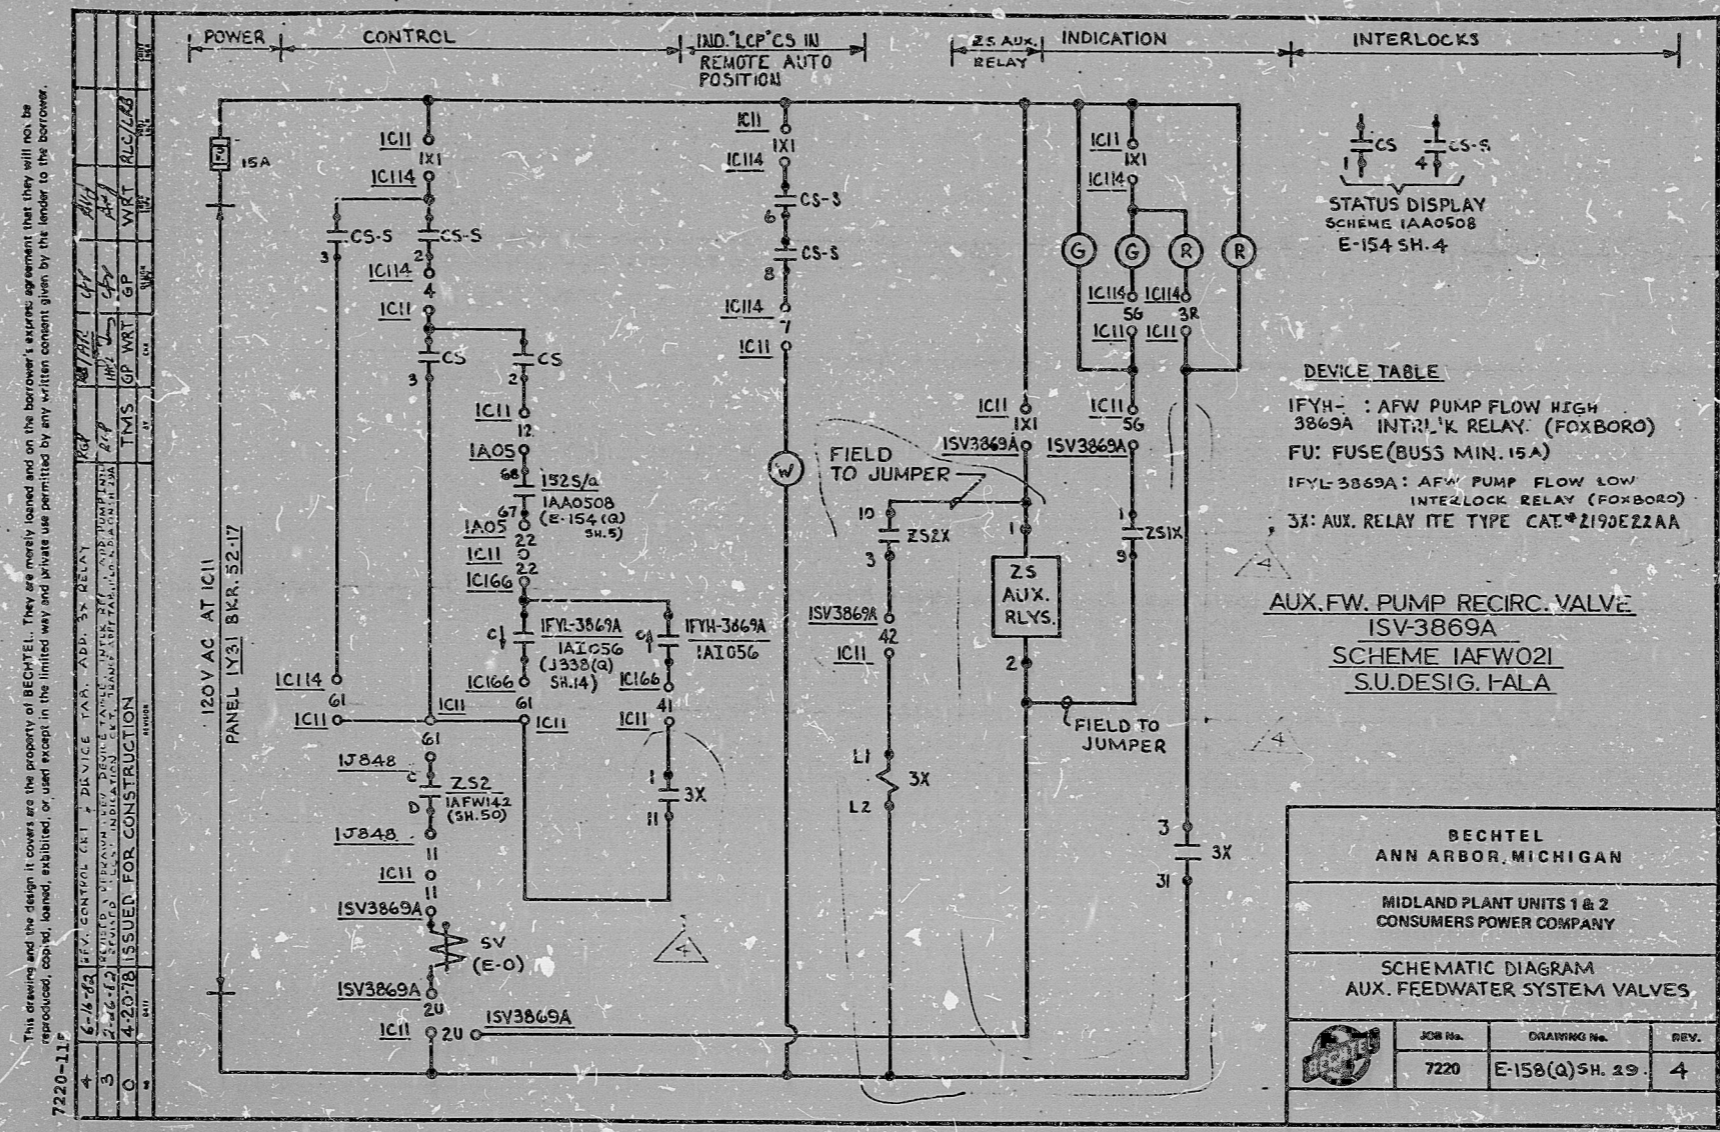

This drawing and the design it covers are the property of BECHTEL. They are hereby loaned and on the borrower's express agreement that they will not be reproduced, copied, loaned, leased, established, or used except in the limited way and private use permitted by any written consent given by the lender to the borrower.

7220-11F

0	ISSUED FOR CONSTRUCTION	WRT	WRT	WRT	WRT

I certify that the image contained on this frame was made in the normal and regular course of business, on the date stated below and that it is an accurate reproduction of the document submitted to reprographics.

PRO
APERTURE
CARD

RIDS

8302070052

