


17"  
11"  
8.5"  
11"  
8.5"  
17"

17"  
11"  
8.5"  
11"  
8.5"  
17"

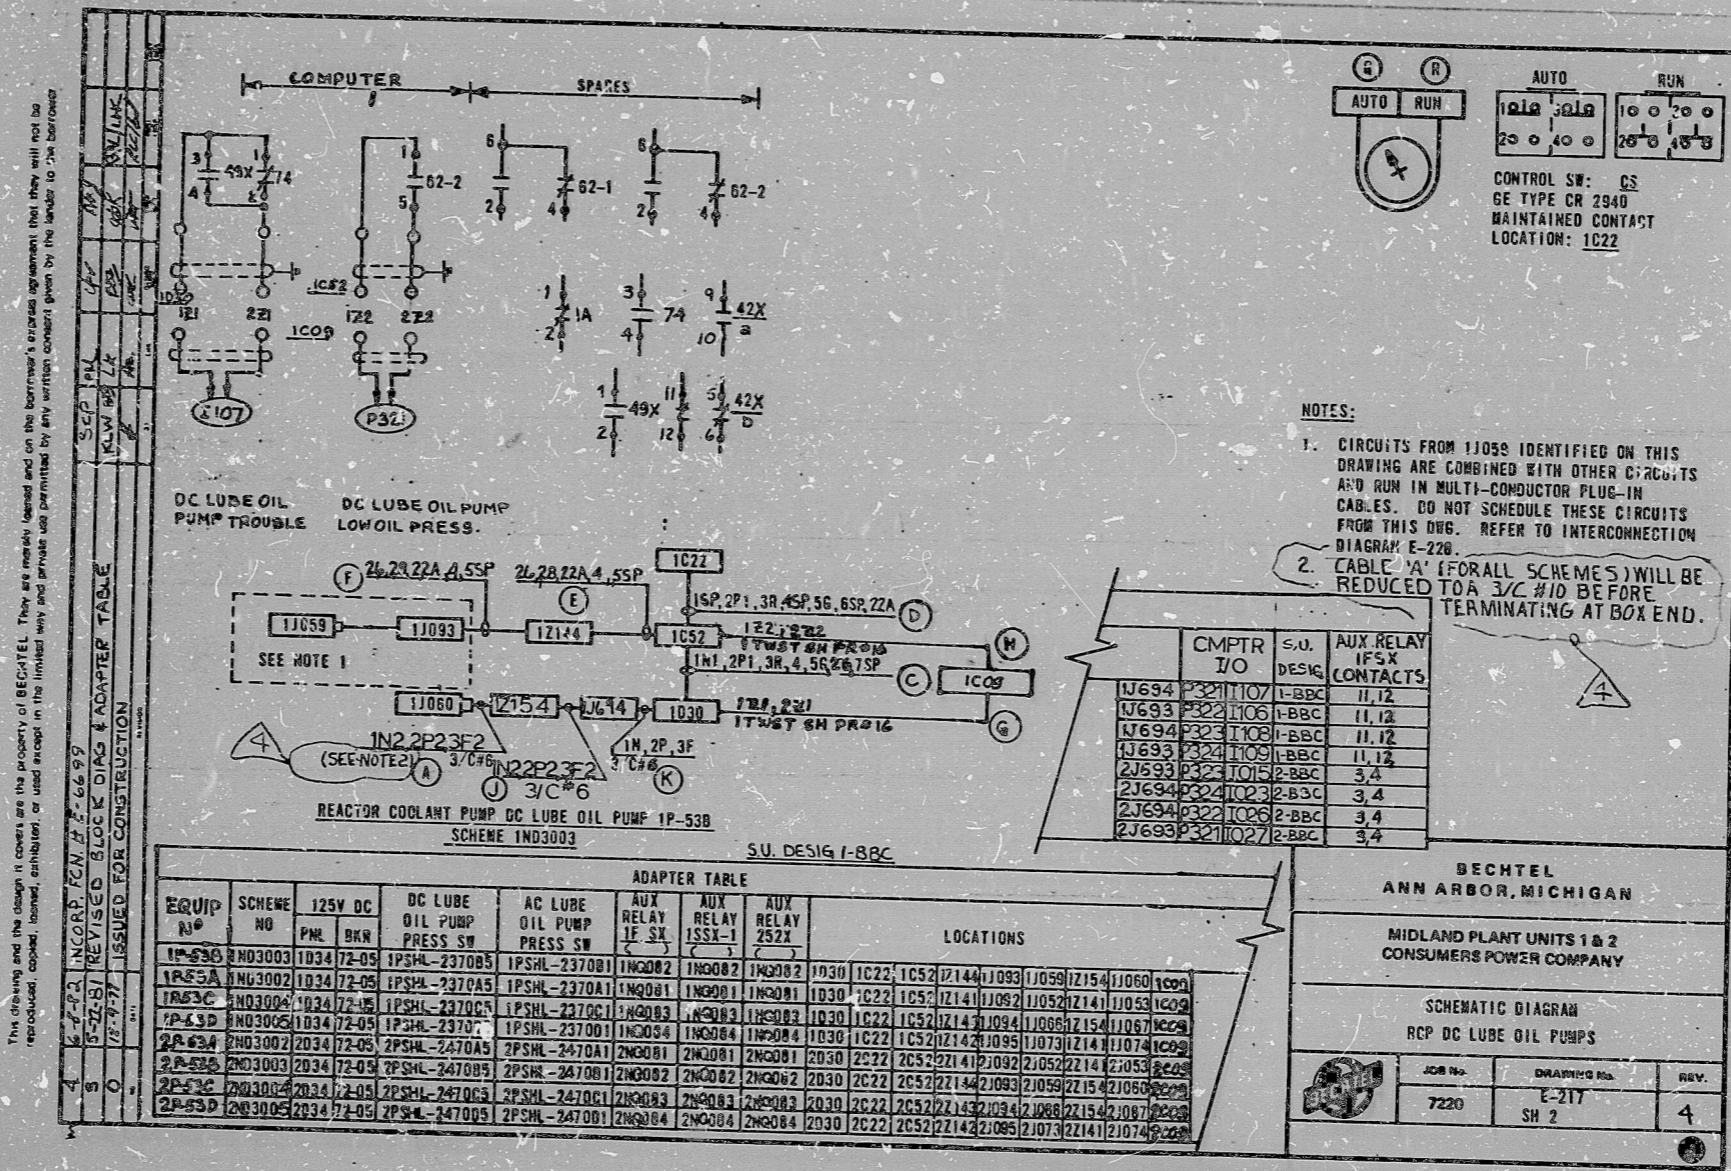

This drawing and the design it covers are the property of BECHTEL. They are made, used and on the borrower's express agreement that they will not be reproduced, copied, loaned, exhibited or used except in the limited way and for the limited purpose permitted by any written consent given by the lender to the borrower.

REV.	DATE	BY	CHKD.	DESCRIPTION

"I certify that the image contained on this frame was made in the normal and regular course of business, on the date stated below and that it is an accurate reproduction of the document submitted to the contractor for filming, by Bechtel Power Corporation."

10-10-82 C. Maston J. H. Thomas  
DATE CAMERA OPERATOR CONTRACTOR'S SUPERVISOR OR MANAGER

16X

PRC APERTURE CARD



RIDS

8302070071

