


The drawing and the design it covers are the property of BECHTEL. They are hereby loaned and on the borrower's express agreement they shall not be copied, reproduced, or used except in the limited way and extent authorized by any written contract given by the lender to the borrower.
 7220-115
 6-7-82 ADDED MAN. BYPASS ALARM CKT. 8 CA. (CROSS-STRUCK)
 4-27-82 INCORP. DEN #4 CHANGE ALARM WINDOW #3
 10-20-81 ISSUED FOR CONSTRUCTION

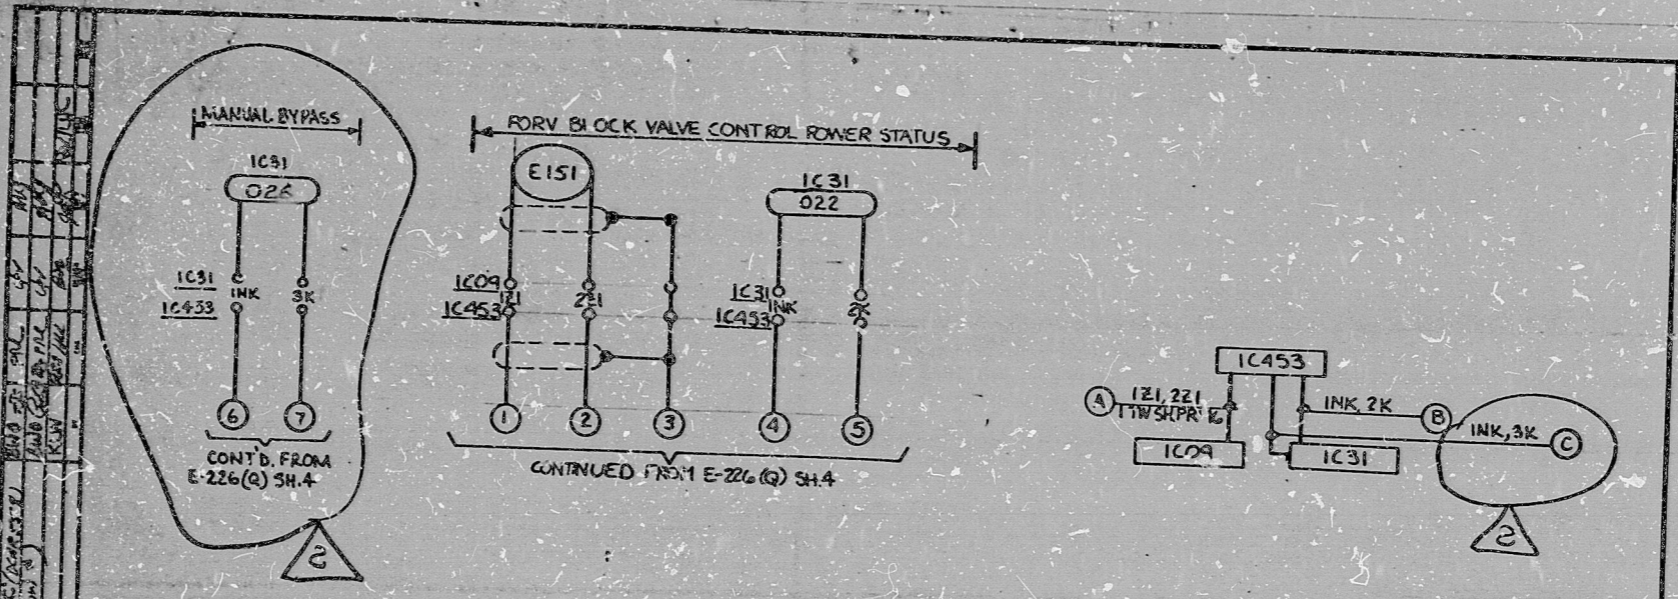

**PRESSURIZER RELIEF BLOCK VALVE
 ALARM CIRCUIT
 SCHEME INQ505
 S.U. DESIG 1-88B**

REFERENCES:
 1. LOGIC DIAGRAM J-006(Q) SH.6

SCHEME	VALVE NO	CHPTR ALARM INPUT NUMBER	ANNUNCIATOR ALARM WINDOW NUMBER		LOCATIONS			S.U. DESIG
			INPUT NUMBER	WINDOW NUMBER	1	2	3	
INQ505	1MO-0111	E 151	022	026	1C09	1C453	1C31	1-88B
INQ506	1MO-0166	E 152	027	026	1C09	1C453	1C31	1-88B
2NQ505	2MO-0211	E 151	022	026	2C09	2C453	2C31	2-88B
2NQ506	2MO-0266	E 152	027	026	2C09	2C453	2C31	2-88B

**BECHTEL
 ANN ARBOR, MICHIGAN**

**MIDLAND PLANT UNITS 1 & 2
 CONSUMERS POWER COMPANY**

**SCHEMATIC DIAGRAM
 REACTOR COOLANT SYSTEM
 MOTOR OPERATED**

DES No.	DRAWING No.	REV.
7220	E-226(Q) SH.5	2

"I certify that the image contained on this frame was made in the normal and regular course of business, on the date stated below and that it is an accurate reproduction of the document submitted to the contractor for filming, by Bechtel Power Corporation.
 6-7-82 C. Clayton J. Williams
 DATE CAMERA OPERATOR CONTRACTOR'S SUP'VR. OR MANAGER

16X

PRO
 APERTURE
 CARD

RIDS

8302070079

