

17"

11"

8.5"

8.5"

11"

17"

17"

11"


11"

8.5"

8.5"

11"

17"

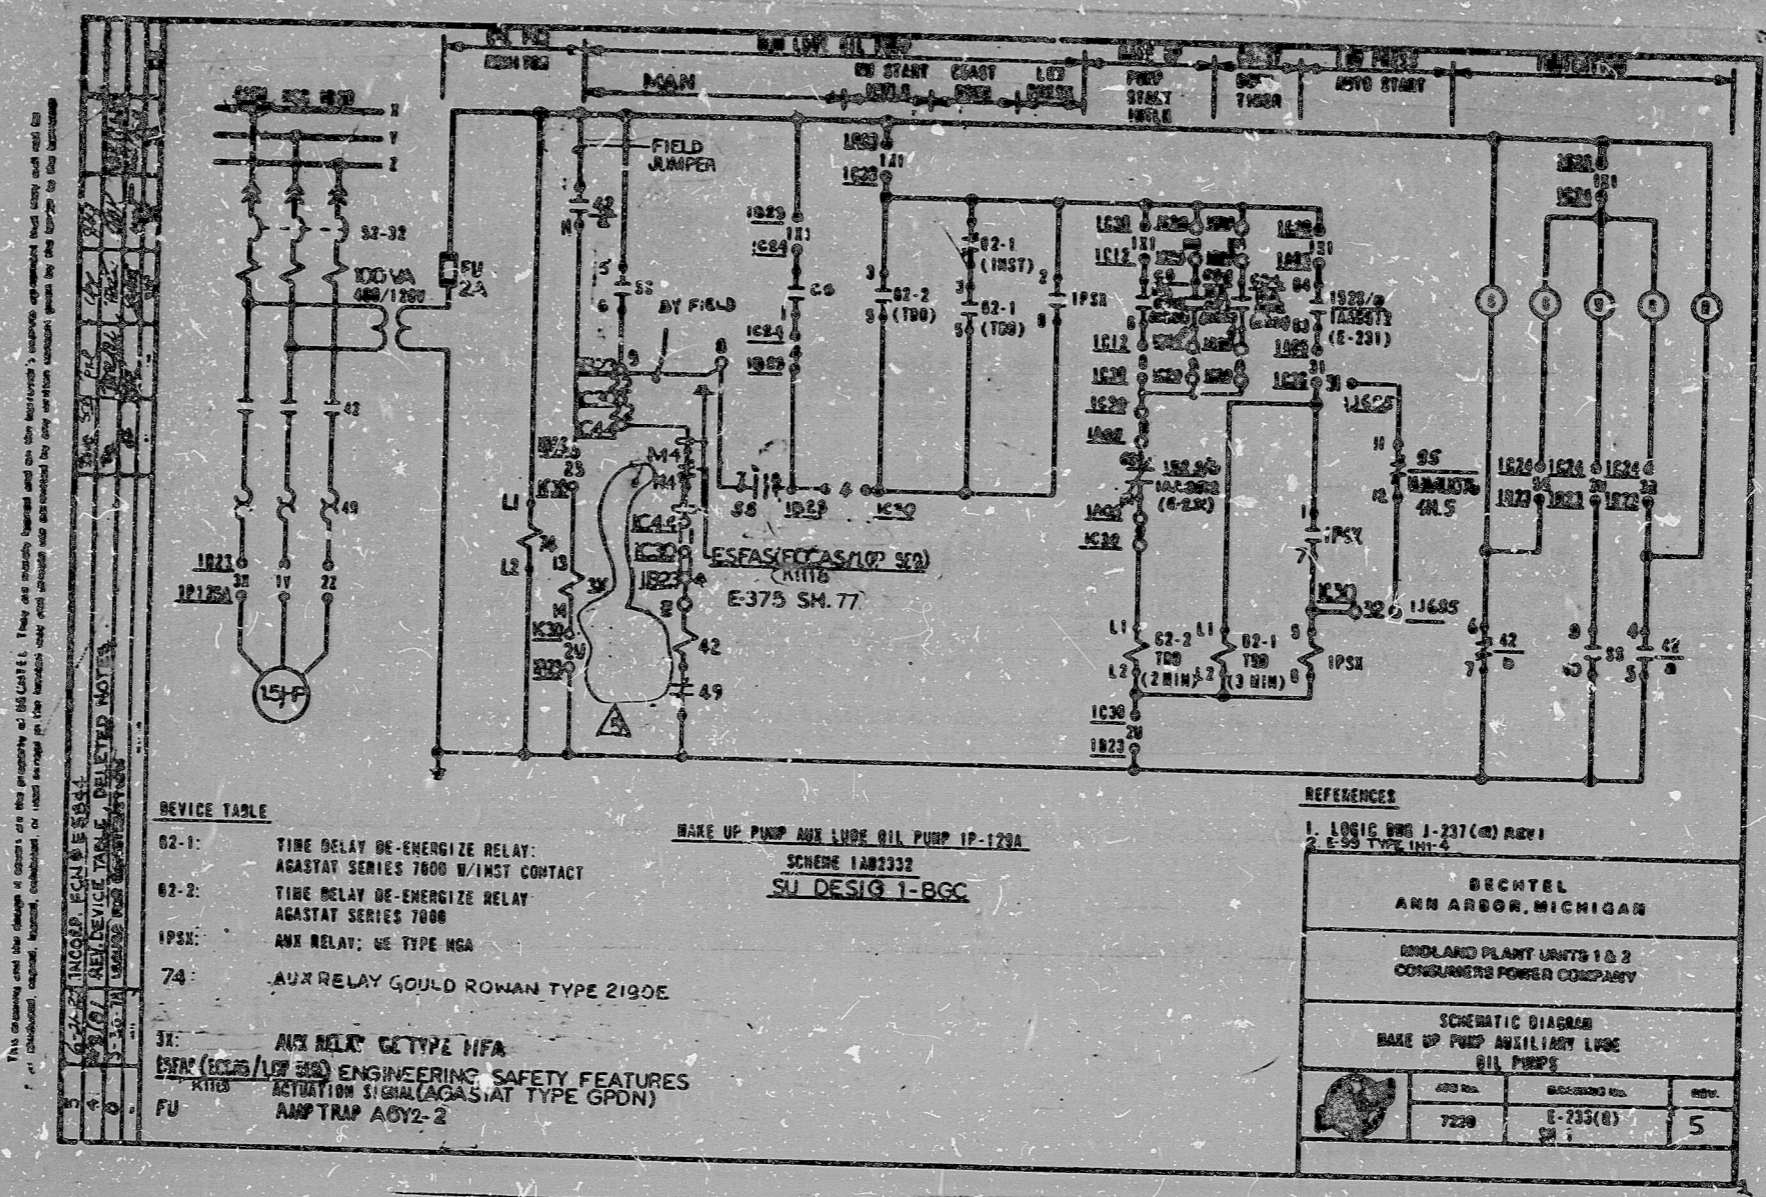

This drawing and the design it covers are the property of BECHTEL. They are made known and on the drawings, various equipment had copy with it for
 Disposal, repair, maintenance, or other service in the event of an emergency and described in any service manual given by the design to the contractor.
 6-21-52 (INCORP. FCN 1-1-53)
 3-10-57 (REV. DEVICE TABLE, DELETED NOT)
 3-10-57 (REV. DEVICE TABLE, DELETED NOT)

DEVICE TABLE

02-1:	TIME DELAY DE-ENERGIZE RELAY; AGASTAT SERIES 7000 W/INST CONTACT
02-2:	TIME DELAY DE-ENERGIZE RELAY AGASTAT SERIES 7000
IPSH:	AUX RELAY; WE TYPE NGA
74:	AUX RELAY GOULD ROWAN TYPE 2190E
31:	AUX RELAY; GE TYPE NFA
E375 (E375/LUB 500) KIT:	ENGINEERING SAFETY FEATURES ACTUATION SIGNAL (AGASTAT TYPE GPDN)
FU:	AMP TRAP A6Y2-2

MAKE UP PUMP AUX LUBE OIL PUMP IP-129A
 SCHEME 1A82332
 SU DESIG 1-BGC

REFERENCES

- 1. LOGIC SWG 1-237 (M) REV 1
- 2. E-99 TYPE INT-C

BECHTEL ANN ARBOR, MICHIGAN		
INDLAND PLANT UNITS 1 & 2 CONSUMERS POWER COMPANY		
SCHEMATIC DIAGRAM MAKE UP PUMP AUXILIARY LUBE OIL PUMPS		
JOB NO. 7229	DRAWING NO. E-235(8) 5	REV. 5

"I certify that the image contained on this frame
 was made in the normal and regular course of
 business, on the date stated below and that it is
 an accurate reproduction of the document submitted
 to the contractor for filming, by Bechtel Power
 Corporation.

DATE: 6-21-52
 CAMERA OPERATOR: M. G. Gieser
 CONTRACTOR'S SUPERVISOR OR MANAGER: J. M. ...

16X

P.A.C.
 APERTURE
 CARD

RIDS

8302079081

