


17"
11"
8.5"
8.5"
11"
17"

17"
11"
8.5"
8.5"
11"
17"

This drawing and the design it covers are the property of BECHTEL. They are hereby licensed out on this licensee's express agreement that they will not be reproduced, copied, lent, exhibited, or used except in the field and in those instances permitted by the licensor in the licensee's possession.

2	3-31-82	INC DCN 02	DEL. R.E.F. DWG.
3	4-14-82	REDRAWN	DEL. R.E.F. DWG.
0	7-6-81	ISSUED FOR CONSTRUCTION	

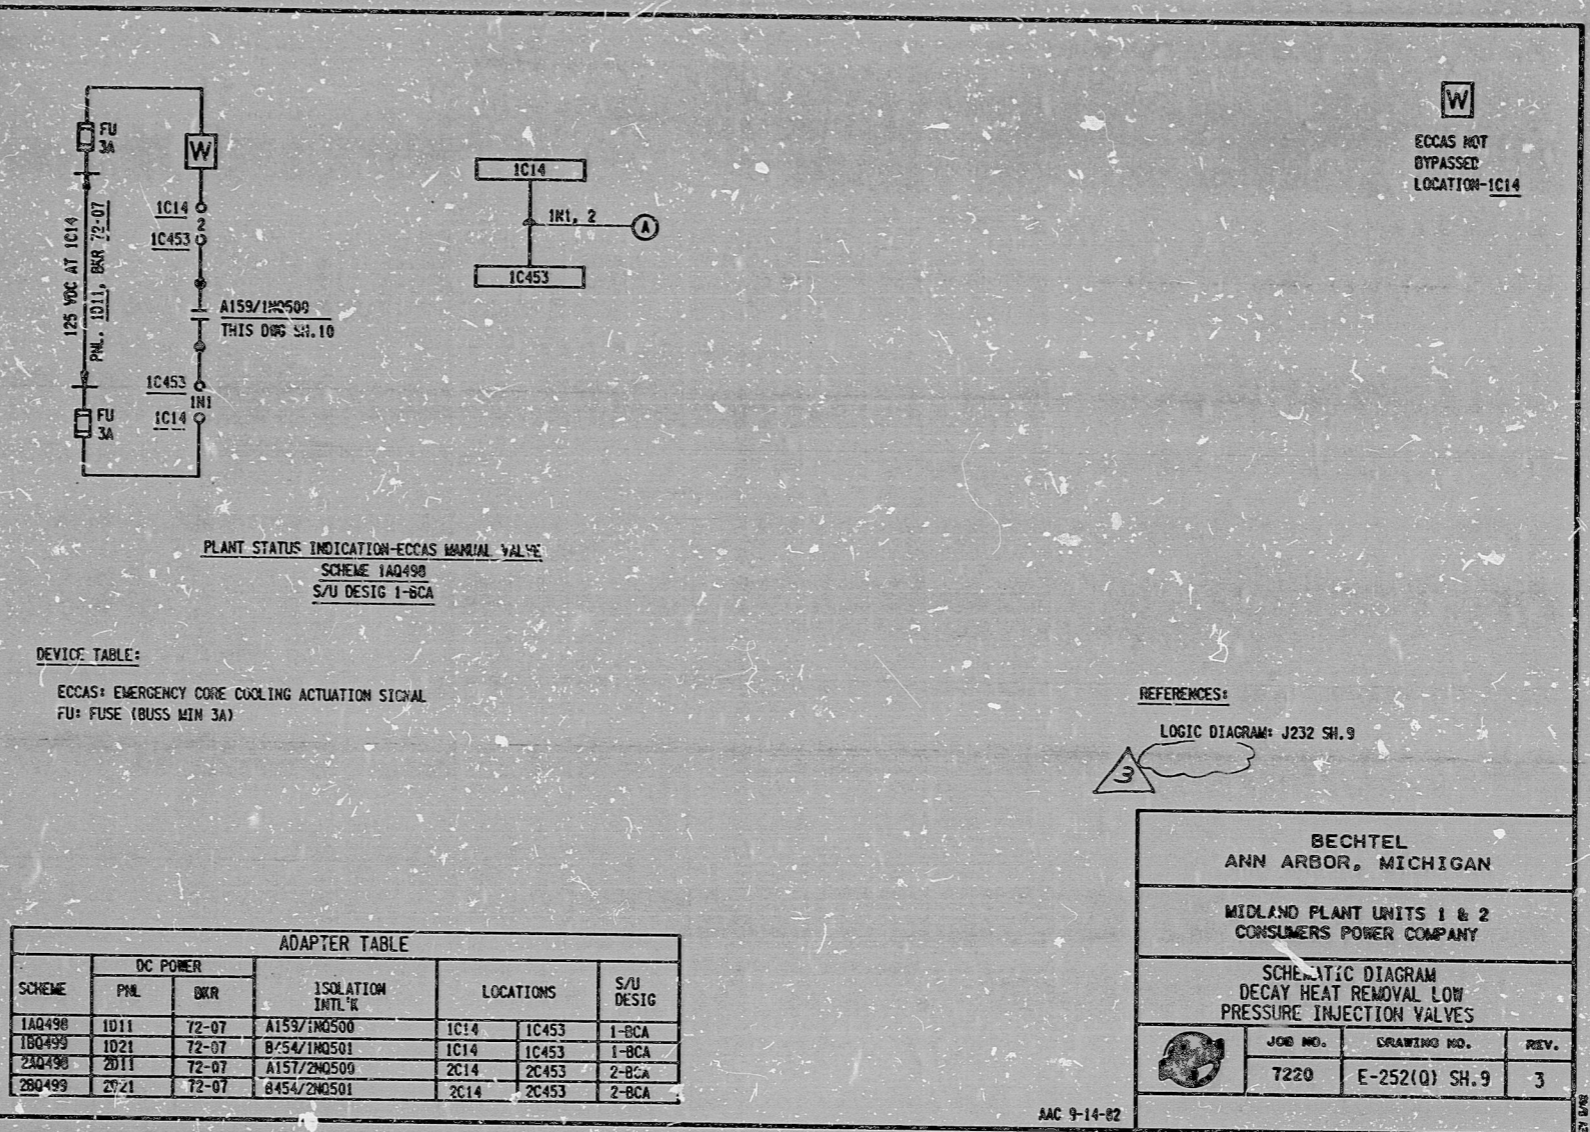

ADAPTER TABLE

SCHEME	DC POWER		ISOLATION INTL'R	LOCATIONS		S/U DESIG
	PHL	BKR		IC14	IC453	
1A0498	1D11	72-07	A159/1M2500	IC14	IC453	1-BCA
1B0499	1D21	72-07	B754/1M2501	IC14	IC453	1-BCA
2A0498	2D11	72-07	A157/2M0500	2C14	2C453	2-BCA
2B0499	2D21	72-07	B454/2M0501	2C14	2C453	2-BCA

BECHTEL
ANN ARBOR, MICHIGAN

MIDLAND PLANT UNITS 1 & 2
CONSUMERS POWER COMPANY

SCHEMATIC DIAGRAM
DECAY HEAT REMOVAL LOW
PRESSURE INJECTION VALVES

JOB NO.	DRAWING NO.	REV.
7220	E-252(Q) SH.9	3

AAC 9-14-82

I certify that the image contained on this frame was made in the normal and regular course of business, on the date stated below and that it is an accurate reproduction of the document submitted to the contractor for filming, by Bechtel Power Corporation.

11-15-82 DATE
 [Signature] CAMERA OPERATOR
 [Signature] CONTRACTOR'S SUPERVISOR OR MANAGER

16X

PRO APERTURE CARD

RIDS

8302070086

