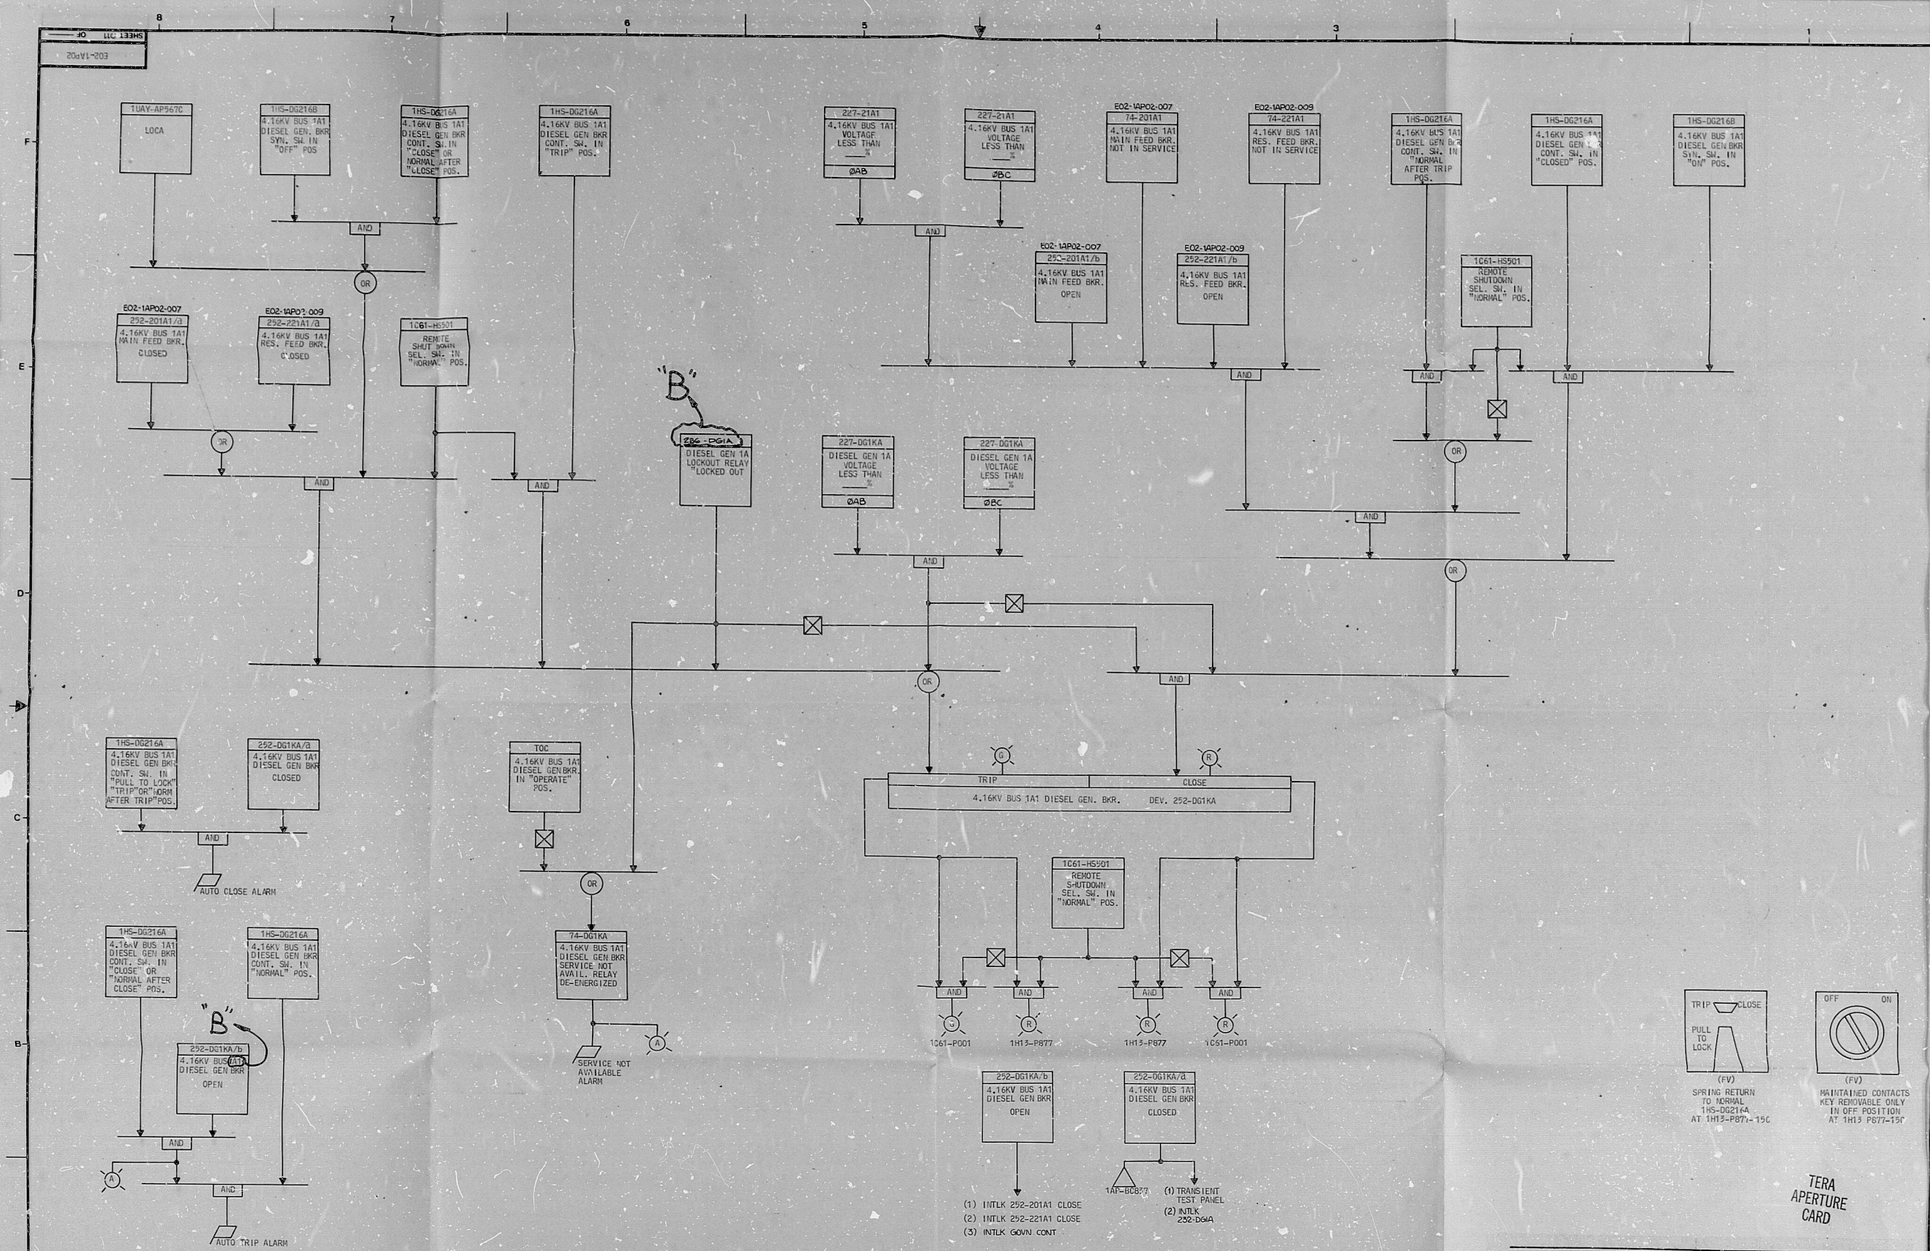

TERA APERTURE CARD

NUCLEAR SAFETY RELATED

EQUIPMENT IS SHOWN ON THIS DRAWING.

(FOR SAFETY CLASSIFICATION SEE EQUIPMENT, VALVE, OR INSTRUMENT LISTS)

DRAWING RELEASE RECORD

REV.	DATE REL'D.	PREPARED	REVIEWED	APPROVED	PURPOSE	FILM

DRAWING RELEASE RECORD

REV.	DATE REL'D.	PREPARED	REVIEWED	APPROVED	PURPOSE	FILM
A	6-24-80	[illegible]	[illegible]	[illegible]	FOR CONSTRUCTION SPEC. K-2999	
B	04-03-81	[illegible]	[illegible]	[illegible]	REV. FOR CONSTRUCTION, SPEC. NO. K-2999.	

PATRICK A. KEVINS 87-36510 REGISTERED PROFESSIONAL ENGINEER OF ILLINOIS

SCALE

PROJECT NUMBER 4556-00

LOGIC BLOCK DIAGRAM
4.16KV BUS 1A1
DIESEL GEN. BREAKER 252-DG1KA
CLINTON POWER STATION, UNIT 1
ILLINOIS POWER COMPANY
CLINTON, ILLINOIS

SARGENT & LUNDY ENGINEERS CHICAGO

DRAWING NO. E02-1AP02 REV. B

SHEET 011 OF

8109010591

Rios

8109010591

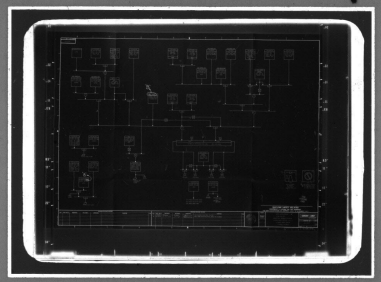

MMM 5824 — FILMSORT® Brand Aperture & Camera Cards and DUPLICARD® Brand Copy Cards — Product of 3M Company, St. Paul, Minn.