
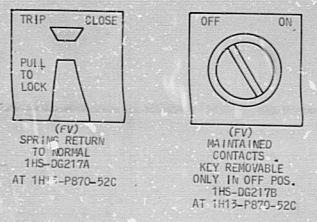


22  
17  
11  
8.5  
11  
17  
22  
34

22  
17  
11  
8.5  
11  
17  
22  
34

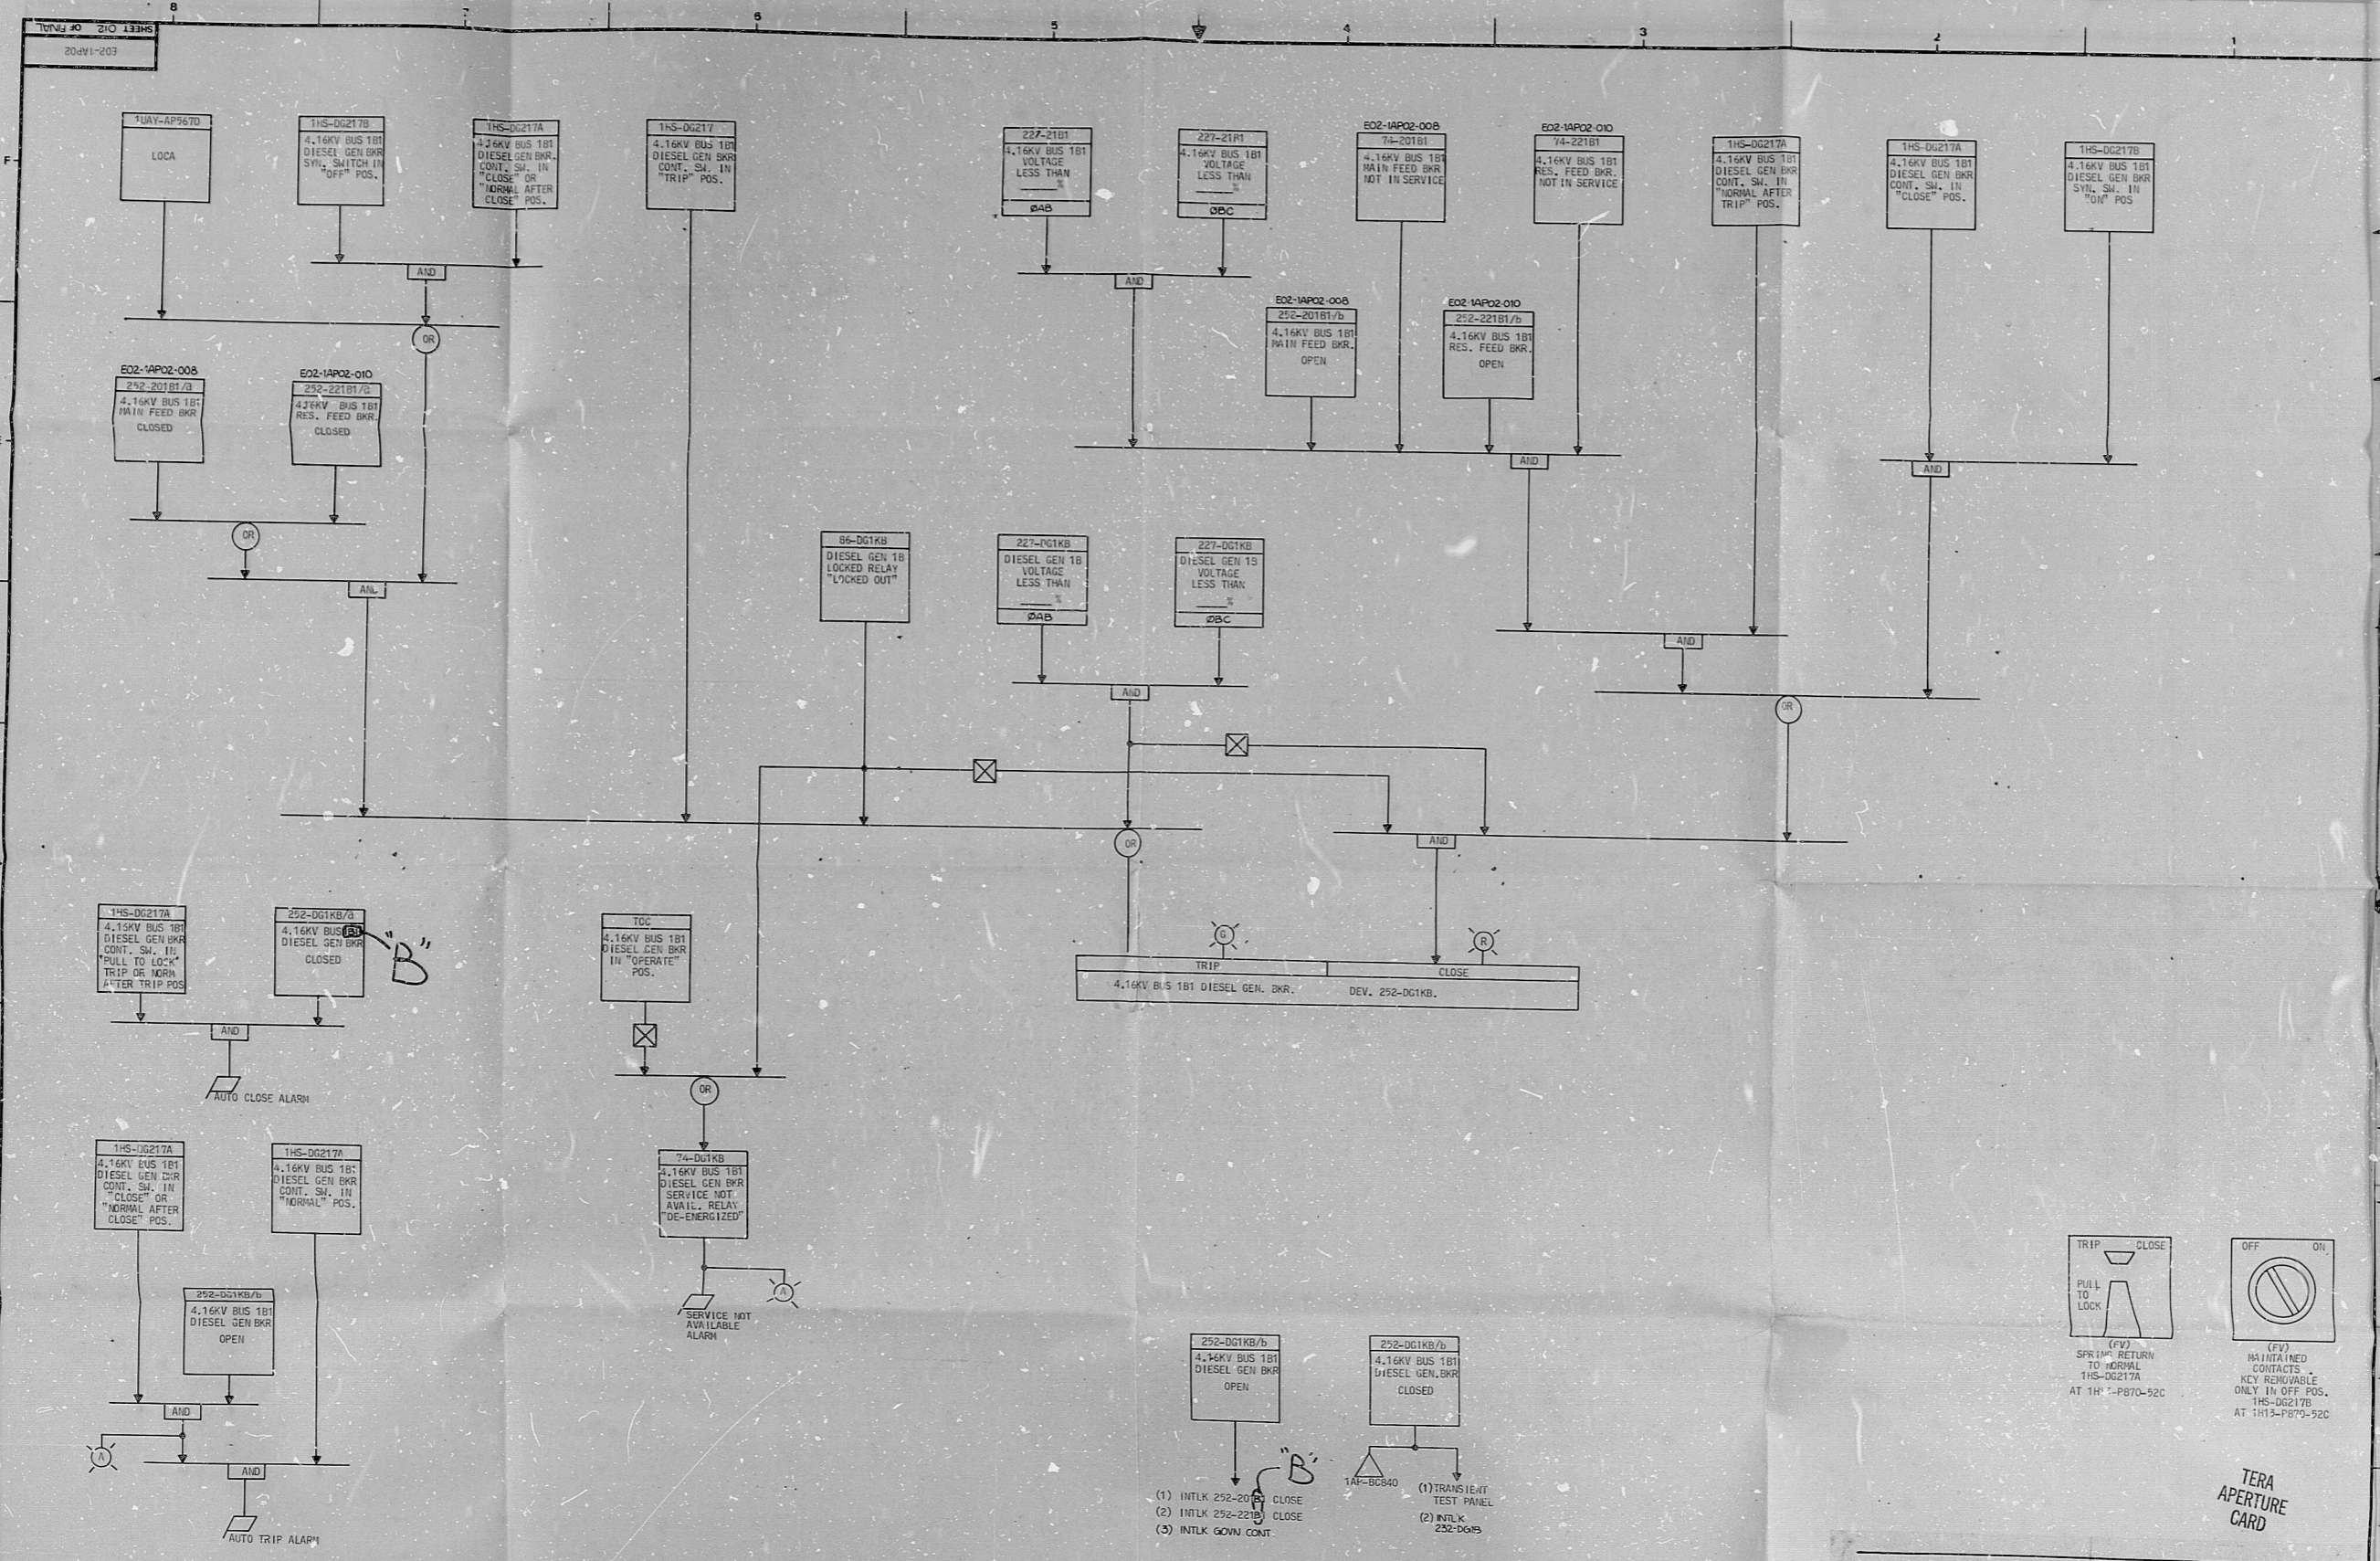


TERA APERTURE CARD

DRAWING RELEASE RECORD						DRAWING RELEASE RECORD					
REV.	DATE RELD.	PREPARED	REVIEWED	APPROVED	PURPOSE	REV.	DATE RELD.	PREPARED	REVIEWED	APPROVED	PURPOSE
A	6-24-80					A	6-24-80				
B	04-03-81					B	04-03-81				

FOR CONSTRUCTION SPEC. N-2993  
REV. FOR CONSTRUCTION SPEC. N-2993

NUCLEAR SAFETY RELATED EQUIPMENT IS SHOWN ON THIS DRAWING. (FOR SAFETY CLASSIFICATION SEE EQUIPMENT, VALVE OR INSTRUMENT LISTS.)

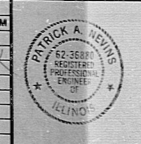

SCALE

PROJECT NUMBER: 252C-000

LOGIC BLOCK DIAGRAM  
416 KV BUS 1B1  
DIESEL GEN BREAKER 252-DG1KB/B  
CLINTON POWER STATION UNIT 1  
ILLINOIS POWER COMPANY  
CLINTON, ILLINOIS

DRAWING NO. REV.  
E02-1A02 B

SHEET 012 OF FINAL  
8109010592

Rids

8109010592

