


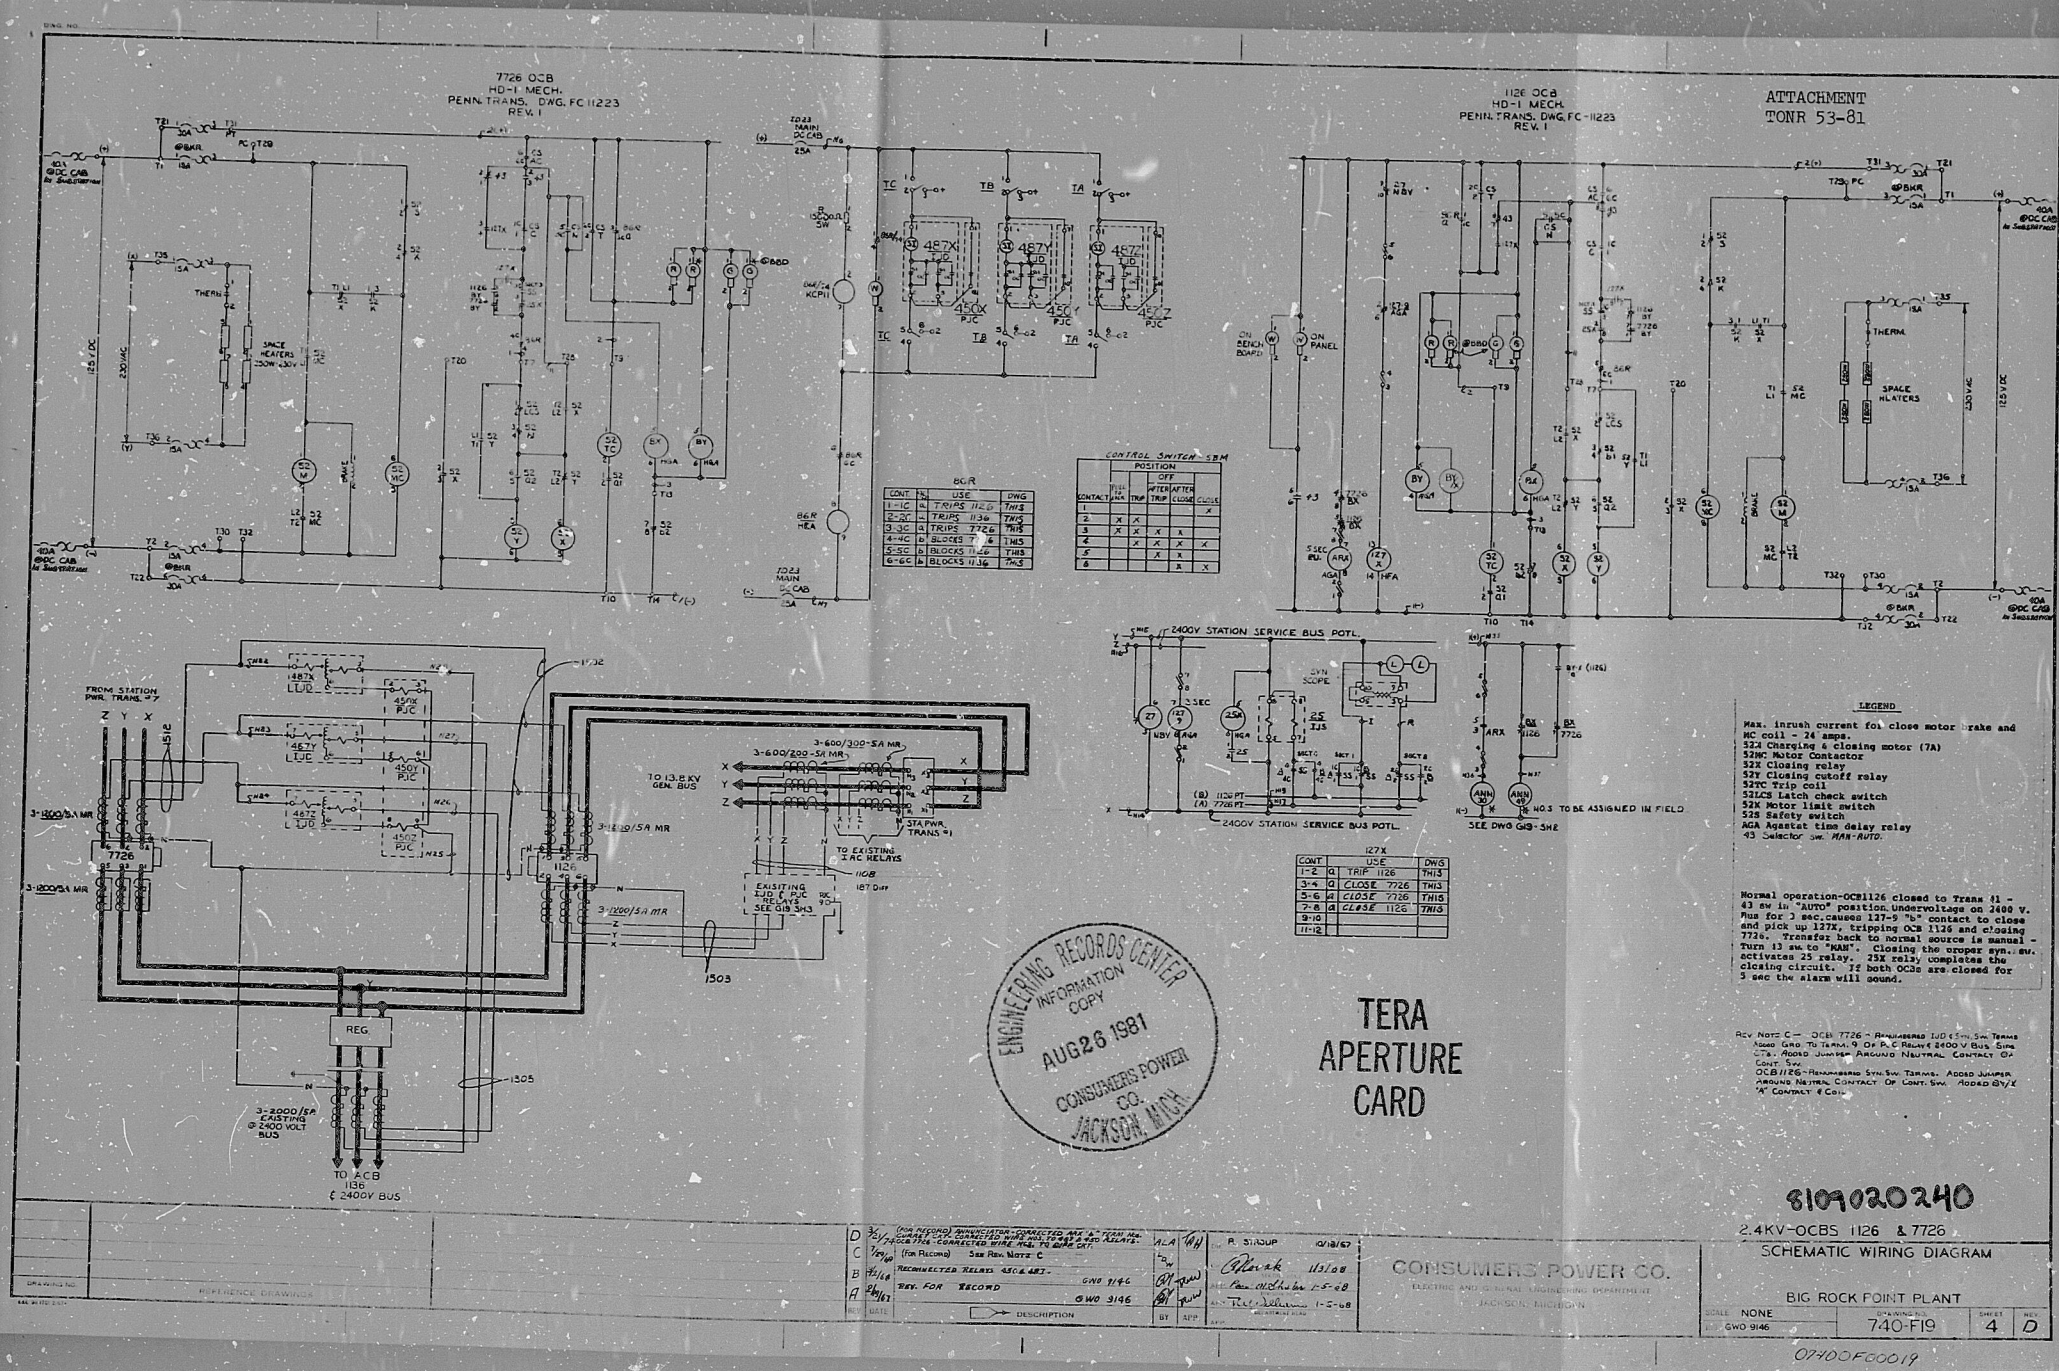

ENGINEERING RECORDS CENTER  
INFORMATION  
COPY  
AUG 26 1981  
CONSUMERS POWER  
CO.  

TERA  
APERTURE  
CARD

RIDS


