

17"

11"

8.5"

8.5"

11"

17"

17"


11"

8.5"

8.5"

11"

17"

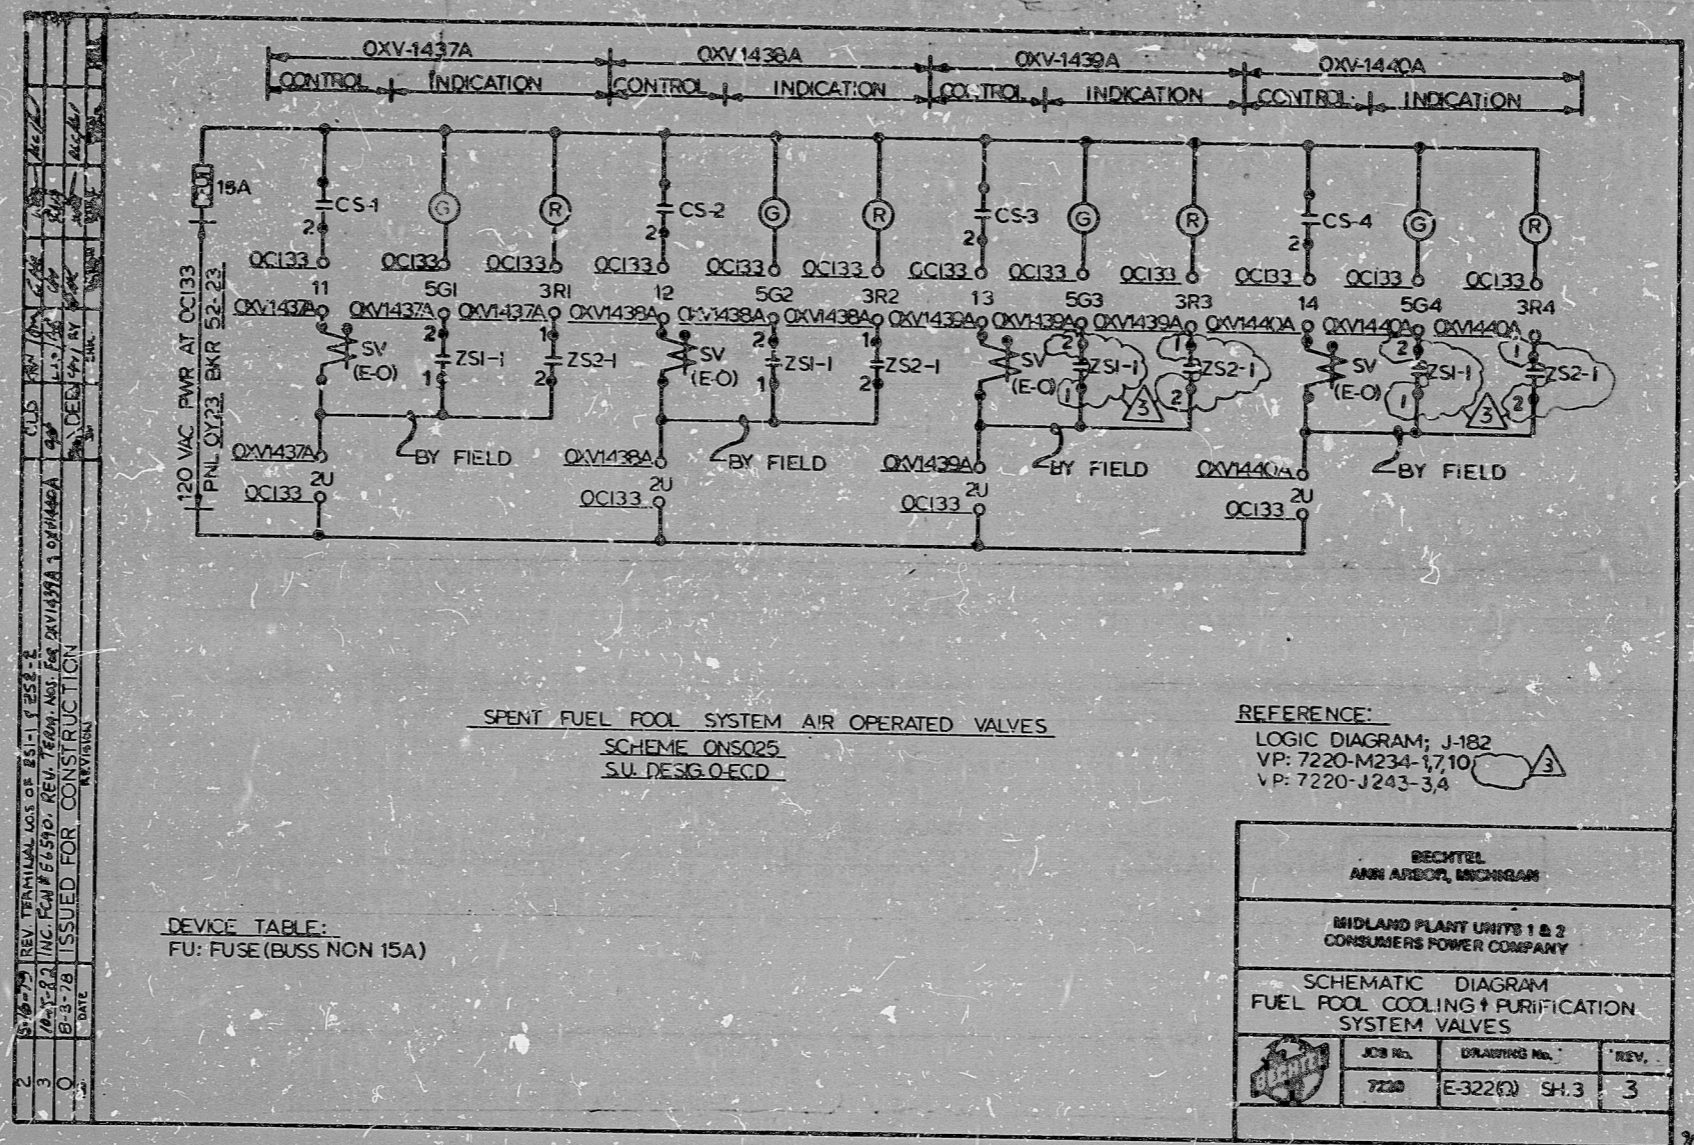

DEVICE TABLE:
FU: FUSE (BUSS NON 15A)

I certify that the image contained on this frame was made in the normal and regular course of business, on the date stated below and that it is an accurate reproduction of the document submitted to the contractor for filming, by Bechtel Power Corporation.

10-17-82 C. Clifton J. A. Thomas
DATE CAMERA OPERATOR CONTRACTOR'S SUPERVISOR OR MANAGER

16X

PRO
APERTURE
CARD

RIDS

8302070132

