


17"
11"
8.5"
8.5"
11"
17"

17"
11"
8.5"
8.5"
11"
17"

This drawing and the data in it remain the property of BECHTEL. They are hereby loaned and on the borrower's express agreement that they will not be reproduced, copied, loaned, established, or used except in the limited way and purpose as permitted by any written consent given by the lender in the borrower's presence.


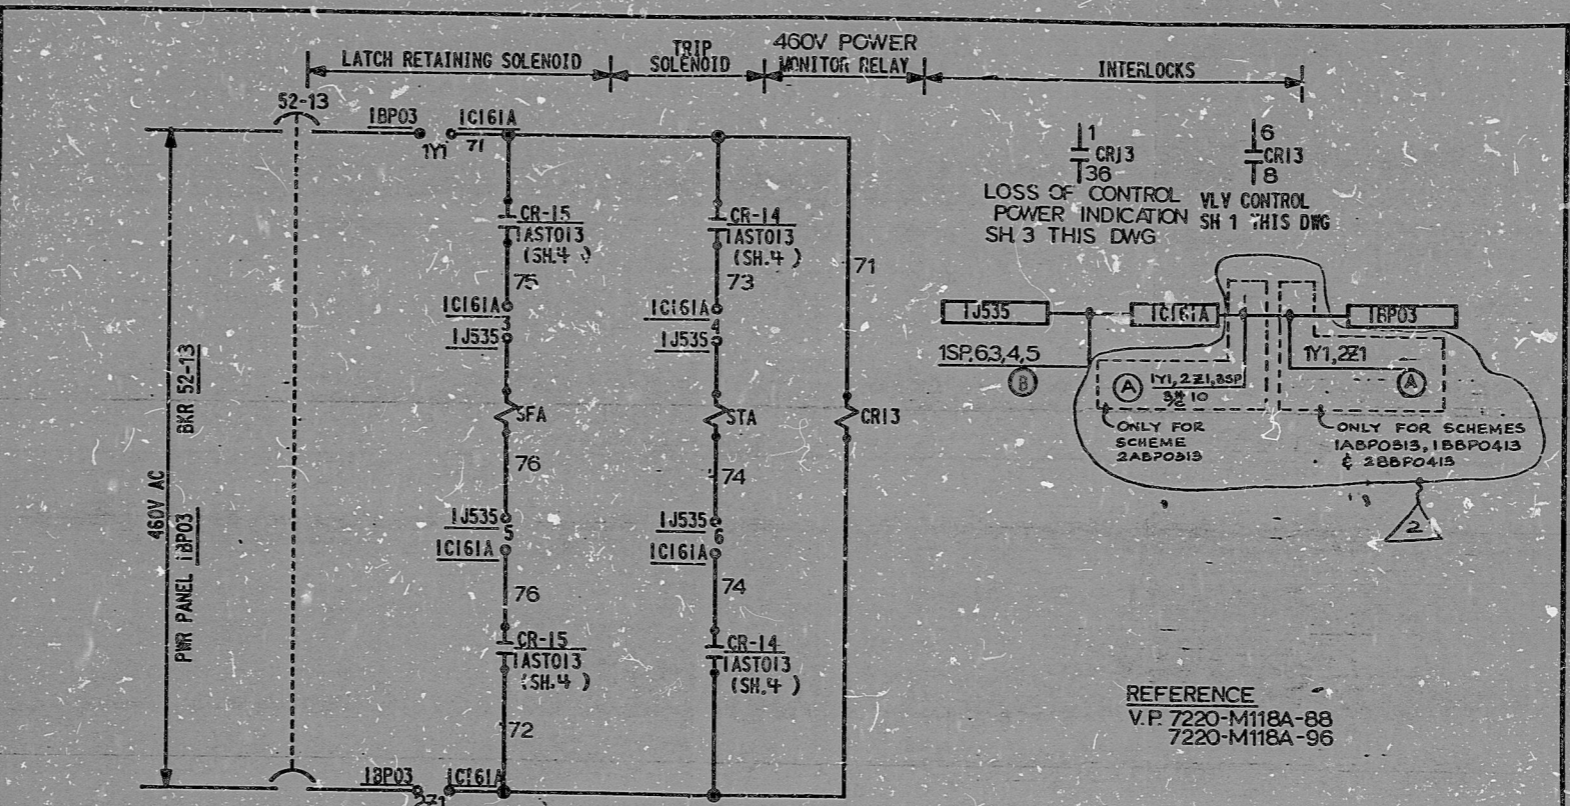

DEVICE TABLE:
 STA-MAIN STEAM LINE VLV
 AC TRIP SOLENOID
 SFA-SFRING LOADING MECHANISM
 LATCH RETAINING SOLENOID
 CR13-CONTROL RELAY

MAIN STEAM ISOLATION VALVE (IXV-3111A) AC TRIP & CONTROL CIRCUIT

SCHEME 1ABP0313
SU DESIG TABB


VALVE NO		SCHEME		460V AC		LOCATIONS		SU DESIG
1	2	1	2	PNL	BR	1	2	
IXV-3111A	1ABP0313	1BP03	52-13	1BP03	1J535	1C161A	1-ABB	
IXV-3111B	1BBP0413	1BP04	52-13	1BP04	1J536	1C161B	1-ABB	
2XV-3211A	2ABP0313	2BP03	52-13	2BP03	2J535	2C161A	2-ABB	
2XV-3211B	2BBP0413	2BP04	52-13	2BP04	2J536	2C161B	2-ABB	

REFERENCE
 V.P. 7220-M118A-88
 7220-M118A-96

BECHTEL ANN ARBOR, MICHIGAN		
MIDLAND PLANT UNITS 1 & 2 CONSUMERS POWER COMPANY		
SCHEMATIC DIAGRAM MAIN STEAM LINE VALVES		
JOB No.	DRAWING No.	REV.
7220	E-352 (9) SH 7	2

I certify that the image contained on this frame was made in the normal and regular course of business, on the date stated below and that it is an accurate reproduction of the document submitted to reprographics.

11-12-82 DATE
 Fuchs Reprographics CORPORATION
 61888

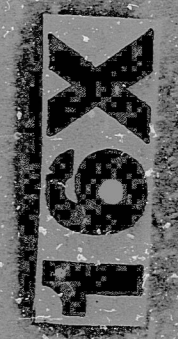

PRO
 APERTURE
 CARD

RIDS

8302070143

