


17"
11"
8.5"
8.5"
11"
17"

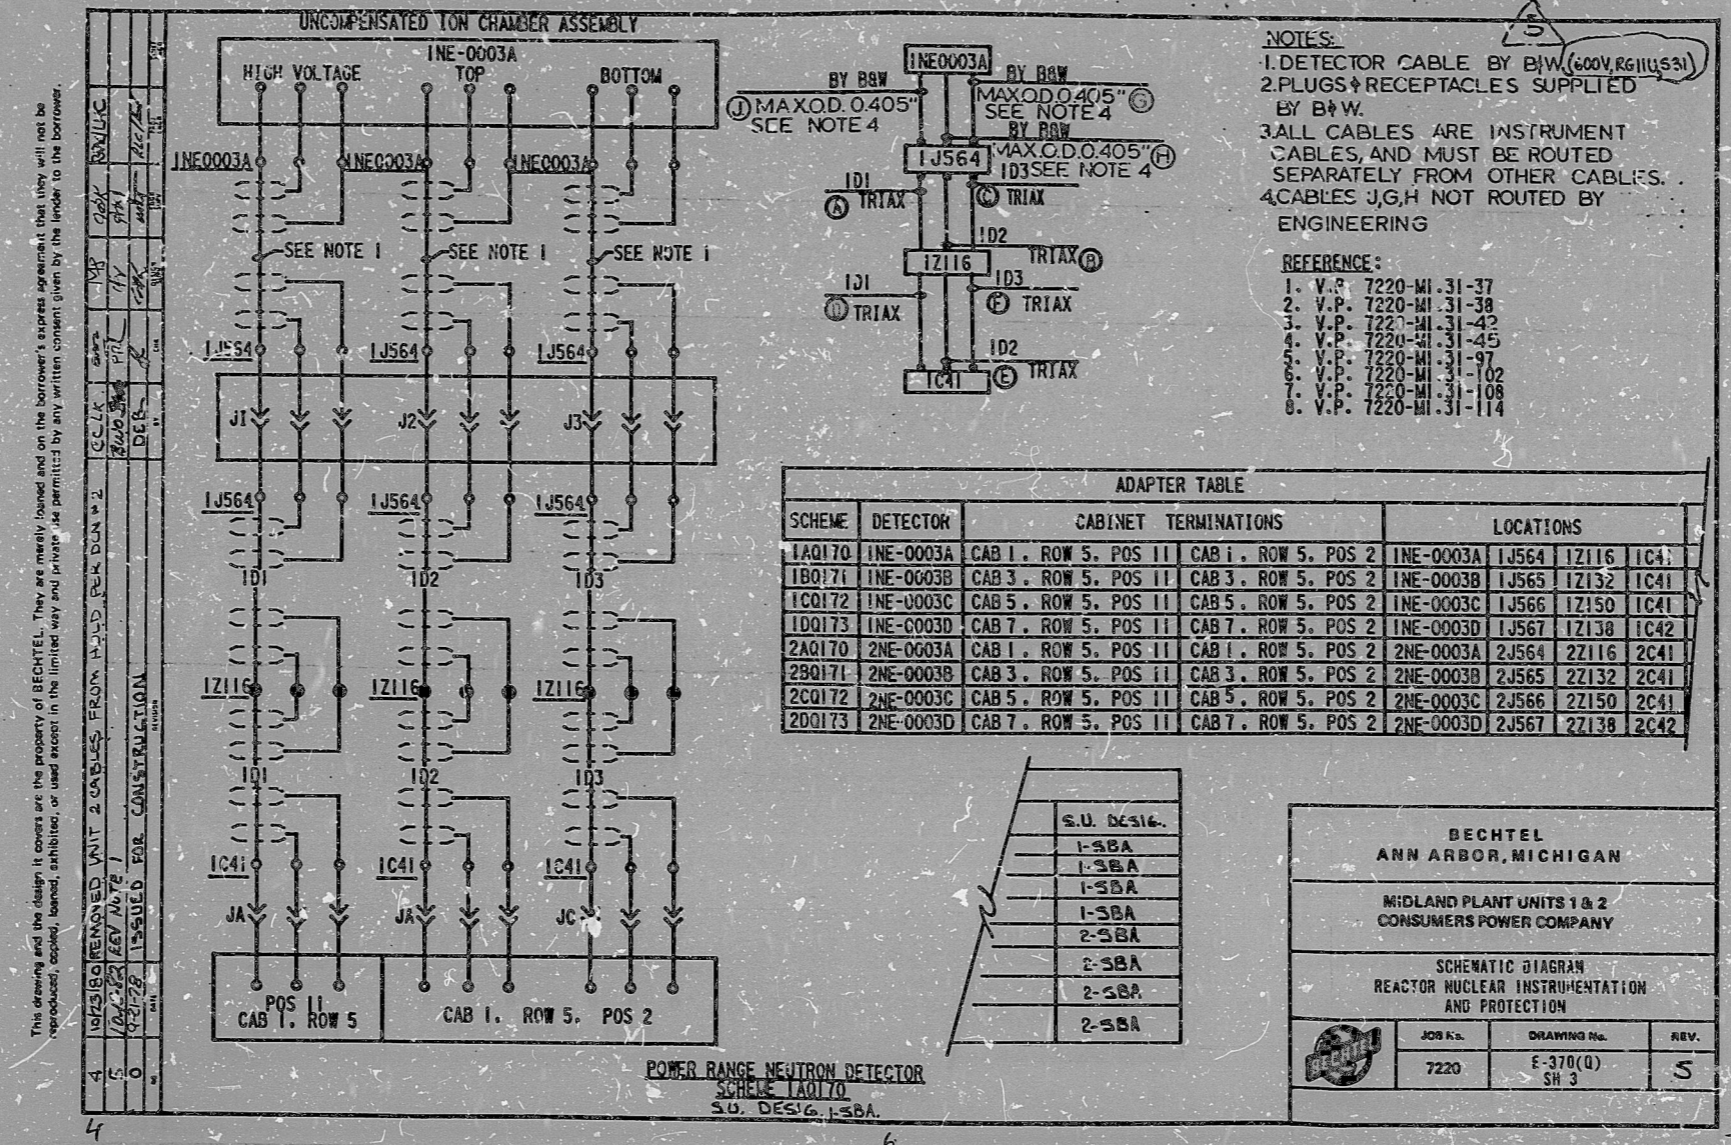

This drawing and the design it covers are the property of BECHTEL. They are made loaned and on the borrower's express agreement that they will not be reproduced, copied, loaned, exhibited, or used except in the limited way and under the permission given by the lender to the borrower.


- NOTES:**
1. DETECTOR CABLE BY B+W (600V, RG11US31)
 2. PLUGS & RECEPTACLES SUPPLIED BY B+W.
 3. ALL CABLES ARE INSTRUMENT CABLES, AND MUST BE ROUTED SEPARATELY FROM OTHER CABLES.
 4. CABLES J,G,H NOT ROUTED BY ENGINEERING
- REFERENCE:**
1. V.P. 7220-MI-31-37
 2. V.P. 7220-MI-31-38
 3. V.P. 7220-MI-31-42
 4. V.P. 7220-MI-31-45
 5. V.P. 7220-MI-31-97
 6. V.P. 7220-MI-31-102
 7. V.P. 7220-MI-31-108
 8. V.P. 7220-MI-31-114

S.U. DESIG.
1-3BA
1-3BA
1-3BA
2-3BA
2-3BA
2-3BA
2-3BA

BECHTEL
ANN ARBOR, MICHIGAN

MIDLAND PLANT UNITS 1 & 2
CONSUMERS POWER COMPANY

SCHEMATIC DIAGRAM
REACTOR NUCLEAR INSTRUMENTATION
AND PROTECTION

JOB No.	DRAWING No.	REV.
7220	E-370(1) SH 3	5

I certify that the image contained on this frame was made in the normal and regular course of business, on the date stated below and that it is an accurate reproduction of the document submitted to reprographics.

10-28-82 *Fred S. Schone*
DATE OPERATOR
REPROGRAPHICS

16X

PRO
APERTURE
CARD

17"
11"
8.5"
8.5"
11"
17"

RIDS

8302070/65

