


17"
11"
8.5"
8.5"
11"
17"

This drawing and the design it covers are the property of BECHTEL. They are made, copied and on the borrower's behalf, without payment that they will not be reproduced, in whole or in part, without the written consent given by the lender to the borrower.

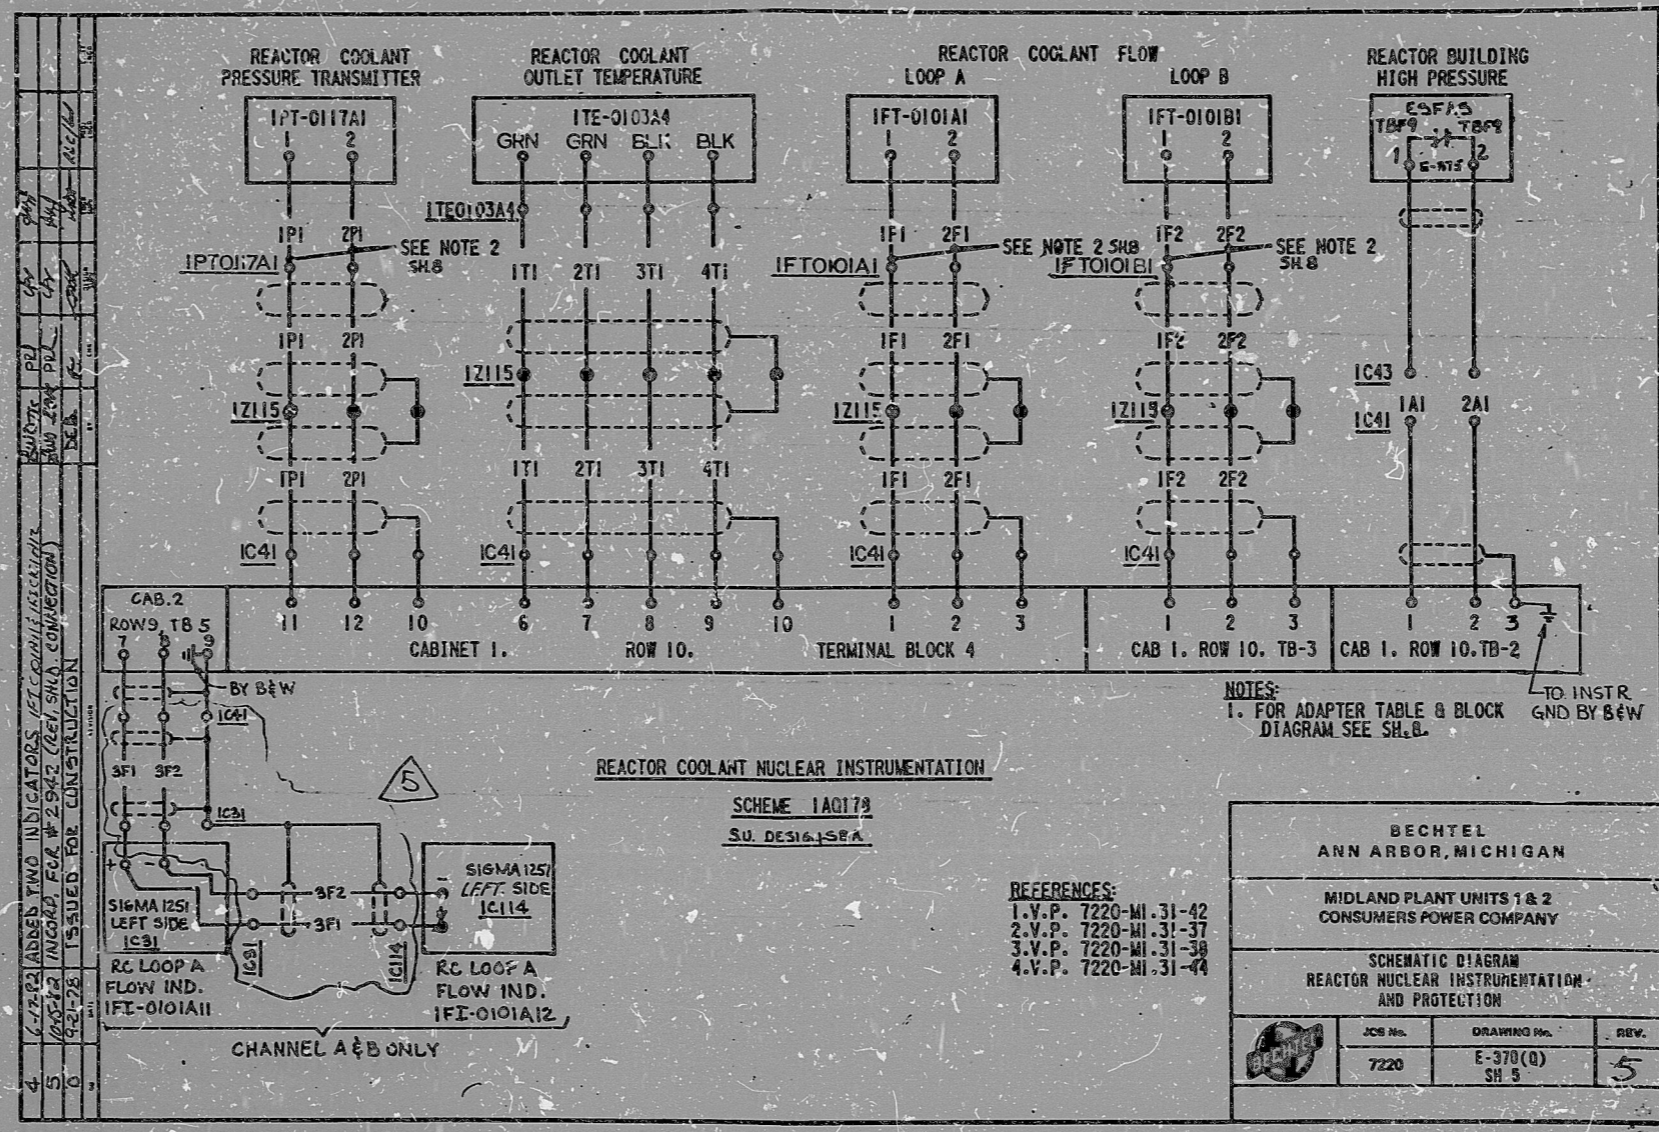

I certify that the image contained on this frame was made in the normal and regular course of business, on the date stated below and that it is an accurate reproduction of the document submitted to reprographics.

10X

10-18-82
Irene S. Schaefer
REPRODUCTION OPERATOR

PRO
APERTURE
CARD

17"
11"
8.5"
8.5"
11"
17"

RIDS

8302070167

