

17"

11"

8.5"

8.5"

11"

17"

17"


11"

8.5"

8.5"

11"

17"

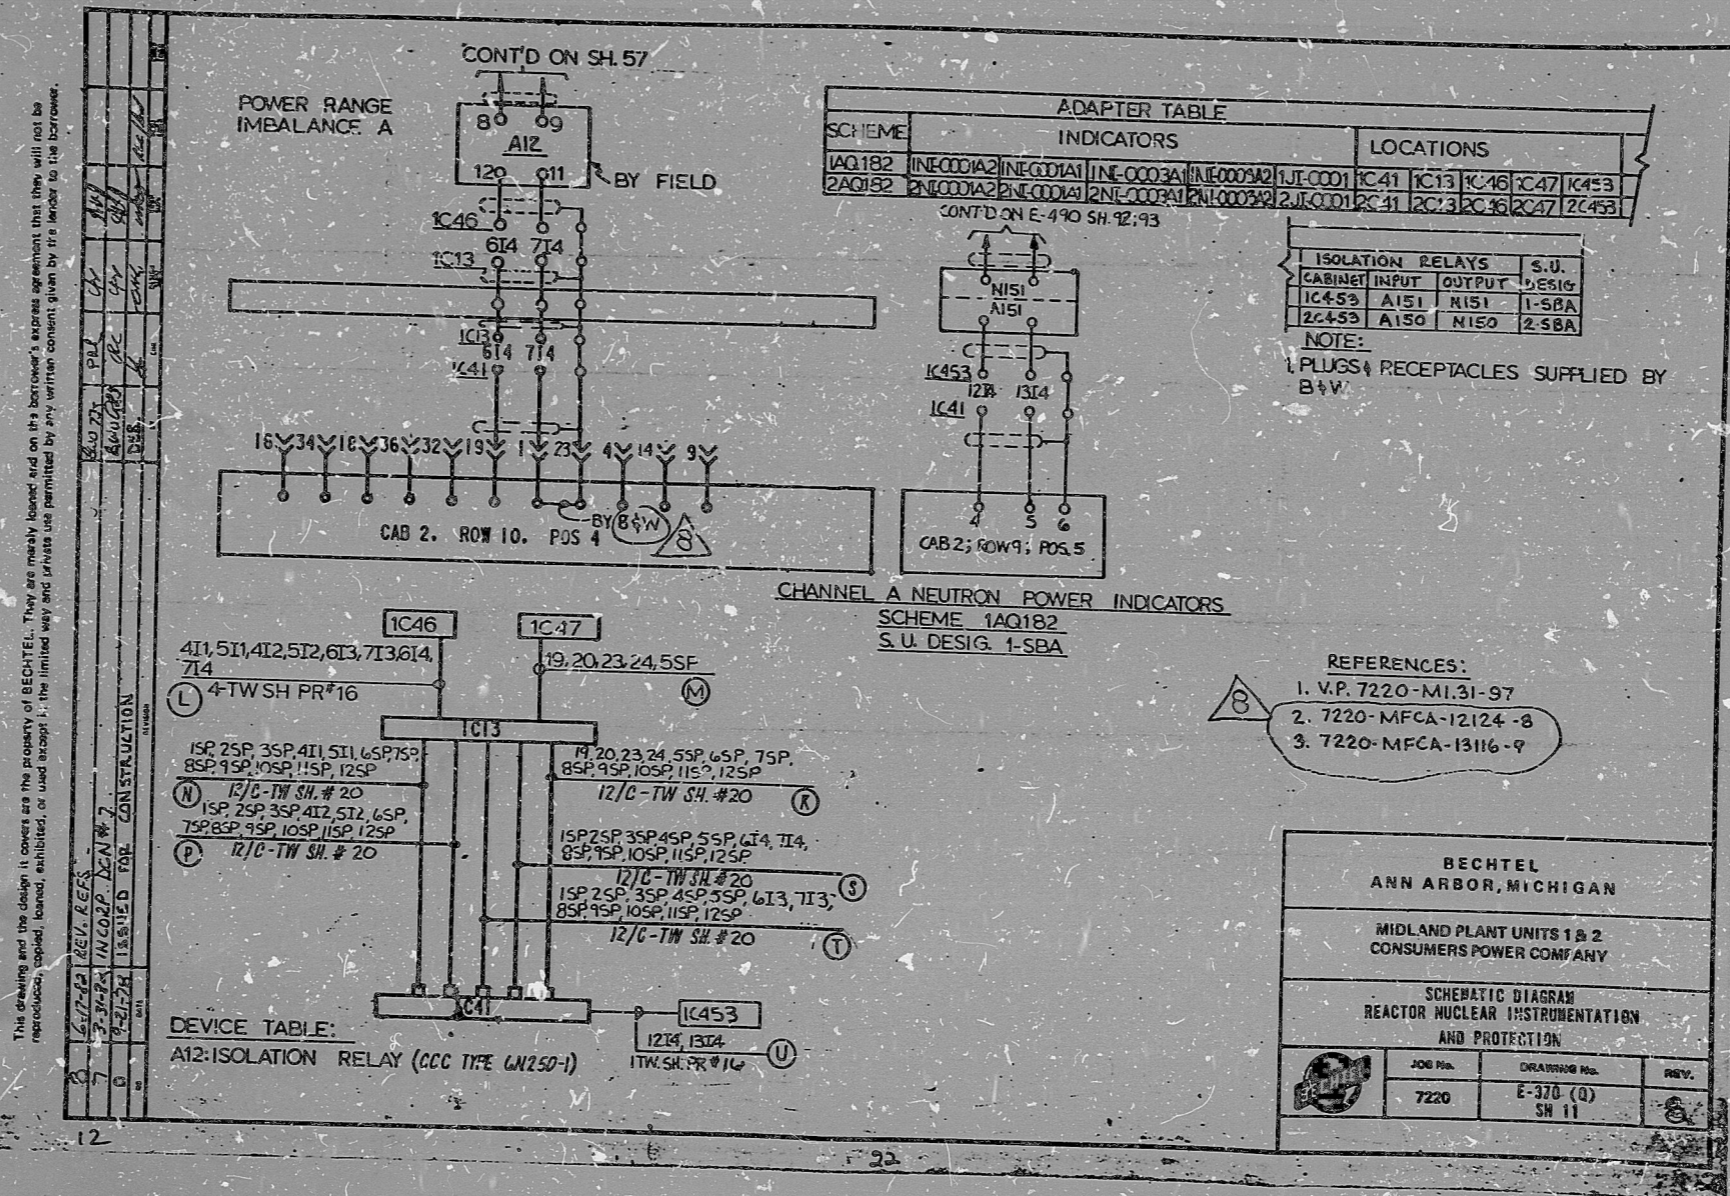

This drawing and the design it covers are the property of BECHTEL. They are hereby loaned and on the borrower's express agreement that they will not be reproduced, copied, loaned, exhibited, or used in any way without the written consent given by the lender to the borrower.

REVISIONS

NO.	DATE	DESCRIPTION	BY	CHKD.

REVISIONS FOR CONSTRUCTION





PRC
APERTURE
CARD

I certify that the image contained on this frame was made in the normal and regular course of business, on the date stated below and that it is an accurate reproduction of the document submitted to reprographics.

RIDS

8302070173

