


17"
11"
8.5"
8.5"
11"
17"

This drawing and the design it covers are the property of BECHTEL. They are hereby loaned and on the borrower's express agreement that they will not be reproduced, copied, altered, simulated, or used except in the limited way and extent permitted by any written consent given by the lender to the borrower.

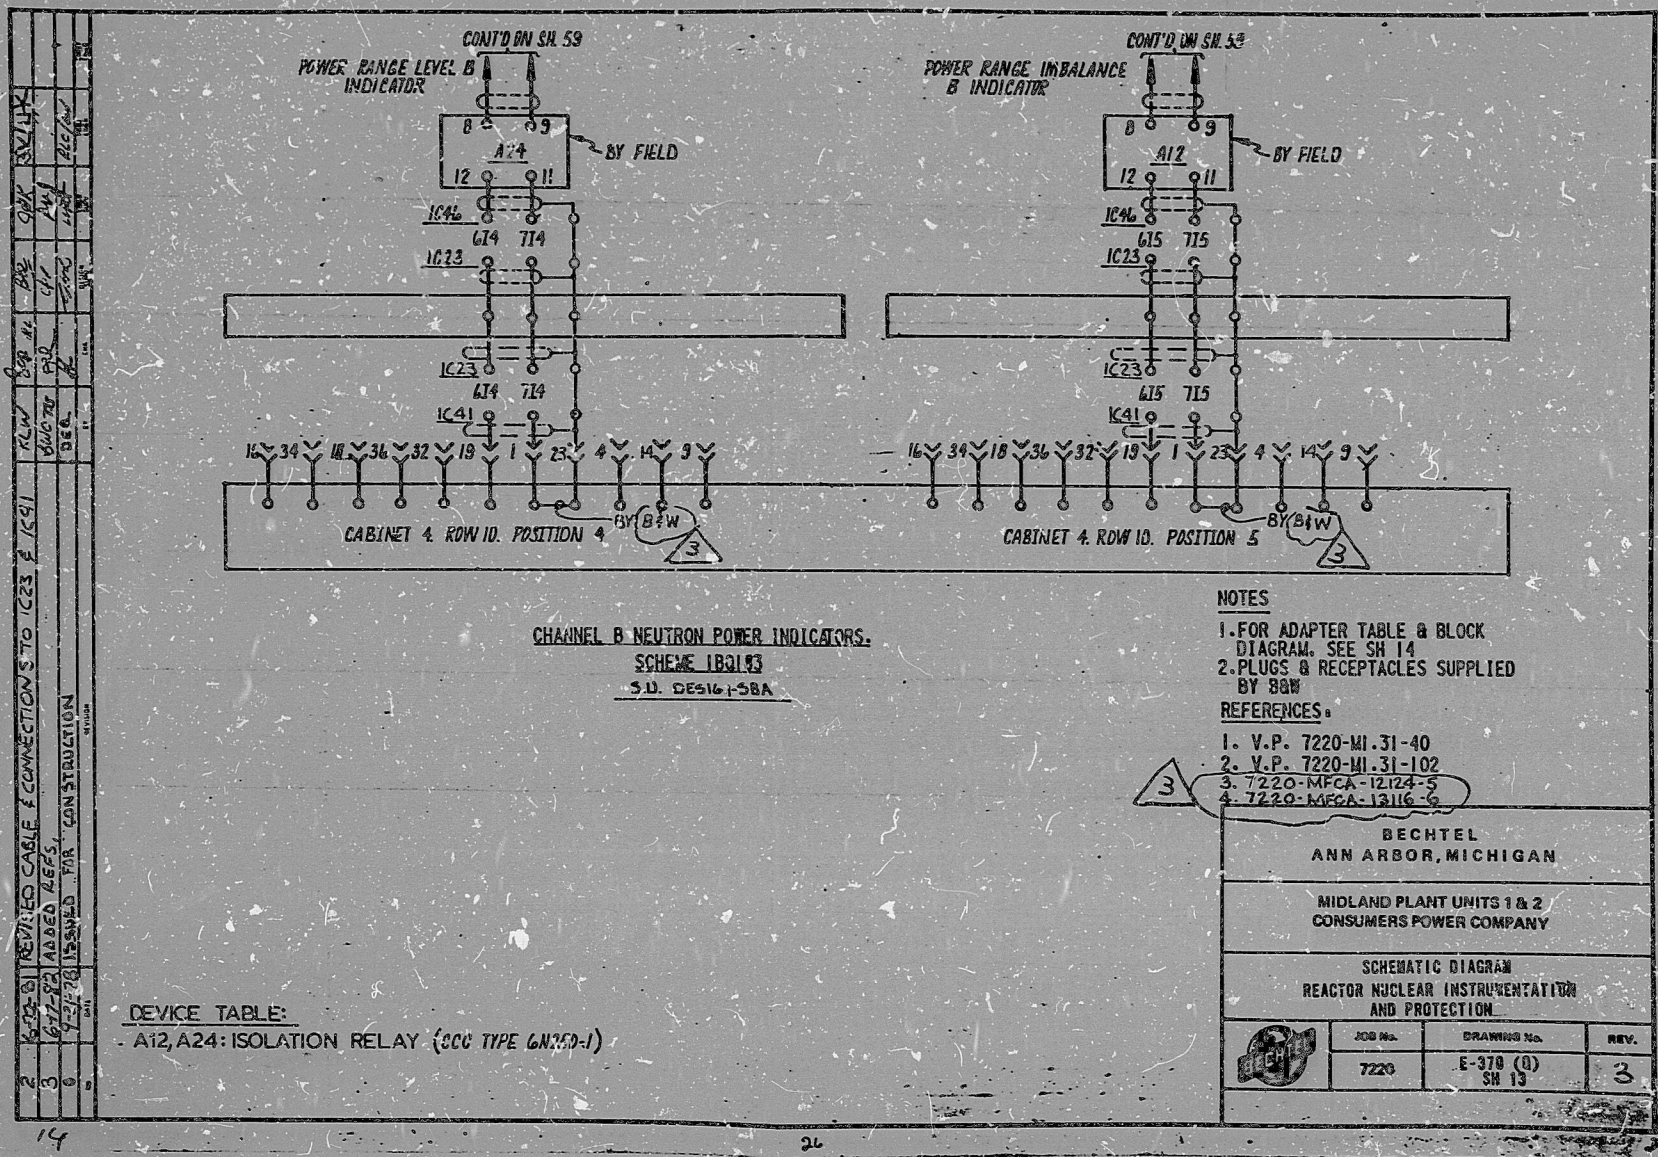

NO.	DESCRIPTION	DATE	BY	CHKD.

DEVICE TABLE:

A12, A24: ISOLATION RELAY (OCC TYPE GN750-1)
--

- NOTES**
- FOR ADAPTER TABLE & BLOCK DIAGRAM. SEE SH 14
 - PLUGS & RECEPTACLES SUPPLIED BY 88W
- REFERENCES:**
- V.P. 7220-MI-31-40
 - V.P. 7220-MI-31-102
 - 7220-MPCA-12124-5
 - 7220-MPCA-13116-6

BECHTEL ANN ARBOR, MICHIGAN		
MIDLAND PLANT UNITS 1 & 2 CONSUMERS POWER COMPANY		
SCHEMATIC DIAGRAM REACTOR NUCLEAR INSTRUMENTATION AND PROTECTION		
JOB No. 7220	DRAWING No. E-370 (D) SH 13	REV. 3

I certify that the image contained on this frame was made in the normal and regular course of business, on the date stated below and that it is an accurate reproduction of the document submitted to reprographics.

17"
11"
8.5"
8.5"
11"
17"

PRO APERTURE CARD

RIDS

8302070175

