


17"
11"
8.5"

17"
11"
8.5"

This drawing and the design it covers are the property of BECHTEL. They are hereby loaned and on the borrower's express agreement that they will not be reproduced, copied, loaned, exhibited, or used except in the limited way and purpose use permitted by any written consent given by the lender to the borrower.

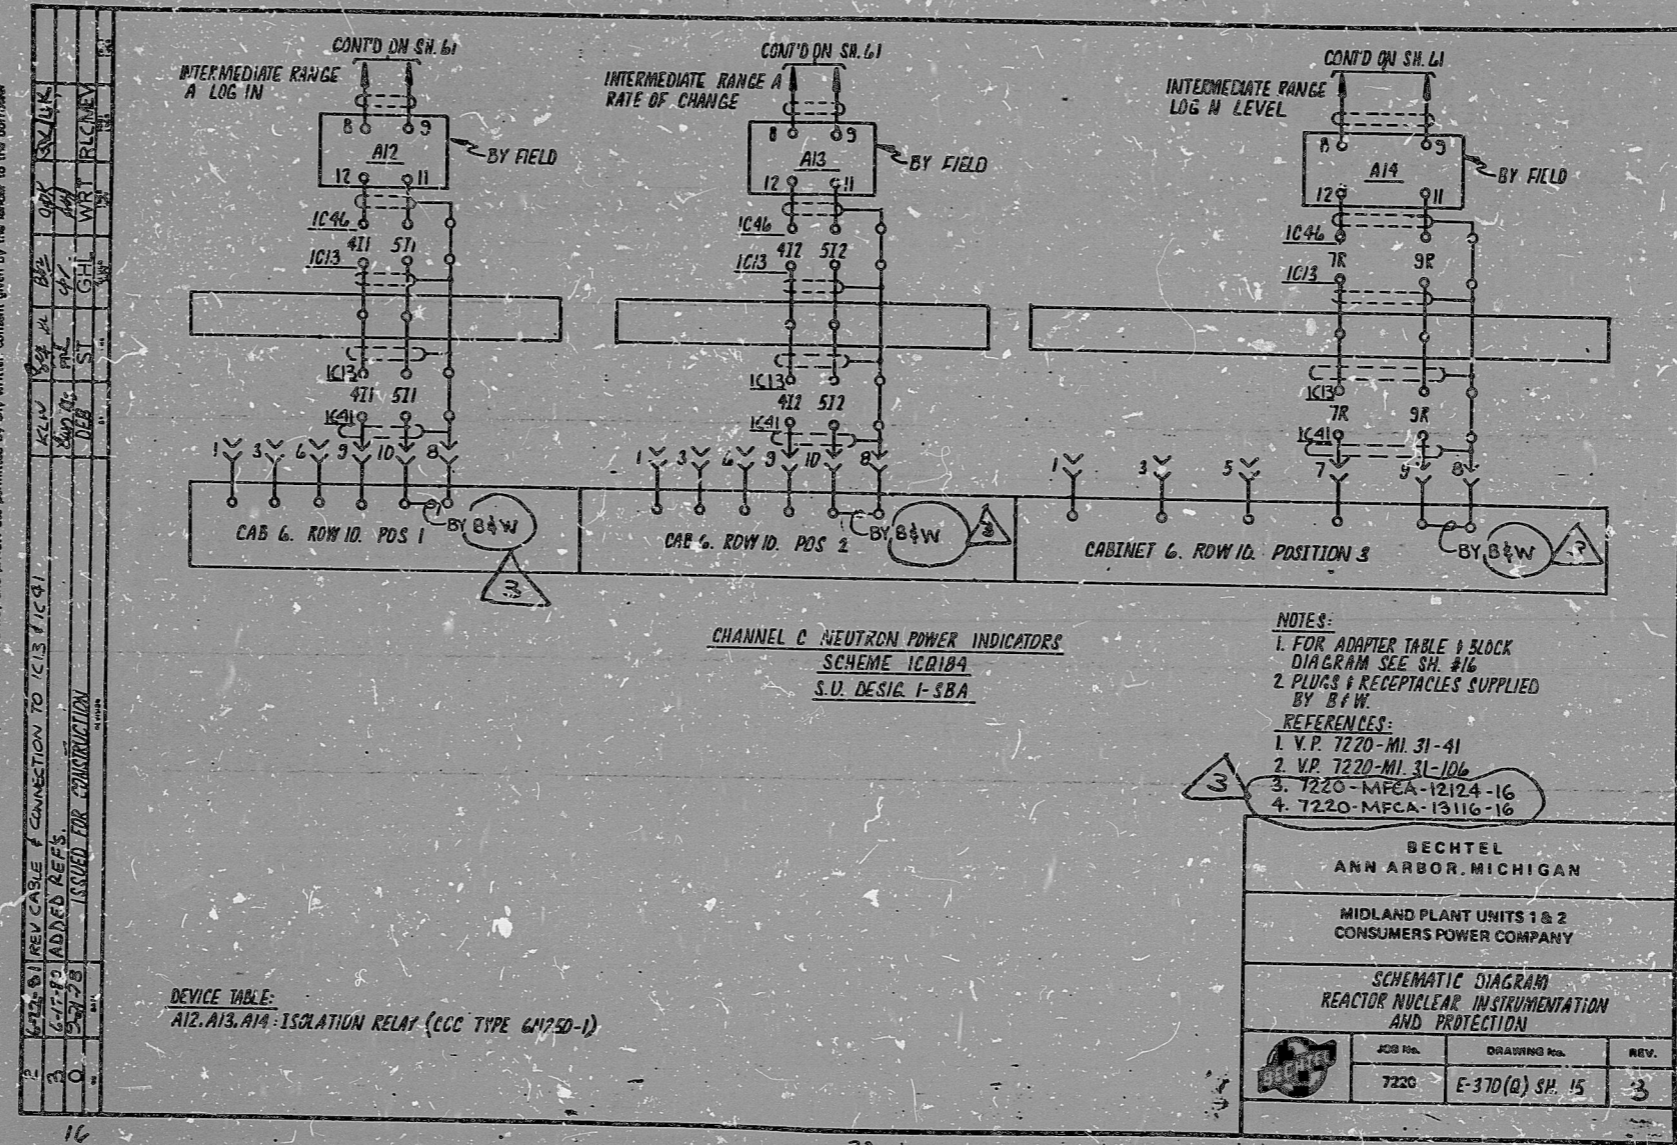

DEVICE TABLE:
AI2, AI3, AI4 - ISOLATION RELAY (CCC TYPE 6M2D-1)

PRC
APERTURE
CARD

I certify that the image contained on this frame was made in the normal and regular course of business, on the data stated below and that it is an accurate reproduction of the document submitted to reprographics.

8.5"
11"
17"

8.5"
11"
17"

RIDS

8302070183

