


17
11
8.5
8.5
11
17

17
11
8.5
8.5
11
17

I certify that the image contained on this frame was made in the normal and regular course of business, on the date stated below and that it is an accurate reproduction of the document submitted to reprographics.

This drawing is the design of BECHTEL. They are hereby licensed and in the licensee's exclusive agreement that they will not be reproduced, copied, loaned, exhibited, or used except in the limited way and amount permitted by any written consent given by the licensor to the licensee.

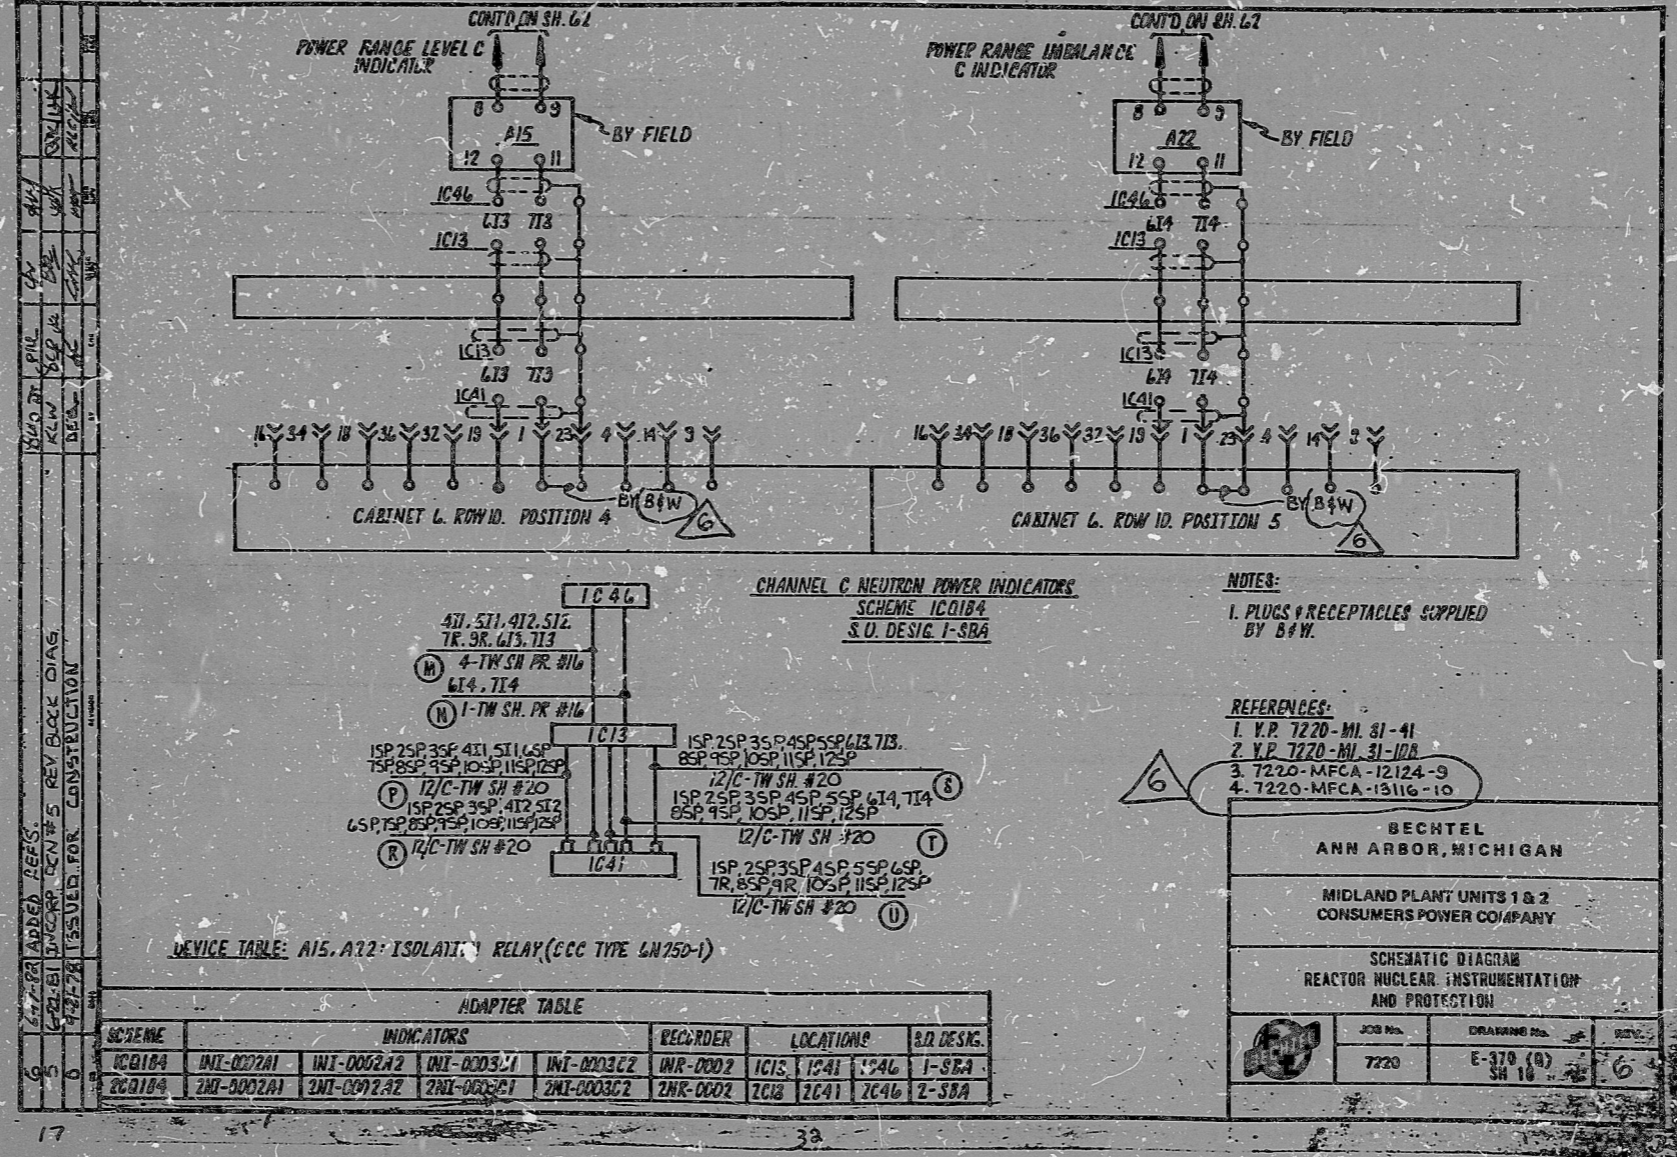

PRC
APERTURE
CARD

RIDS

8302070188

