

17"

11"

8.5"

8.5"

11"

17"

17"

11"


8.5"

8.5"

11"

17"

This drawing and the design it covers are the property of BECHTEL. They are hereby loaned to the borrower's express agreement that they will not be reproduced, copied, loaned, exhibited, or used except in the limited way and phrase use permitted by any written contract given by the lender to the borrower.

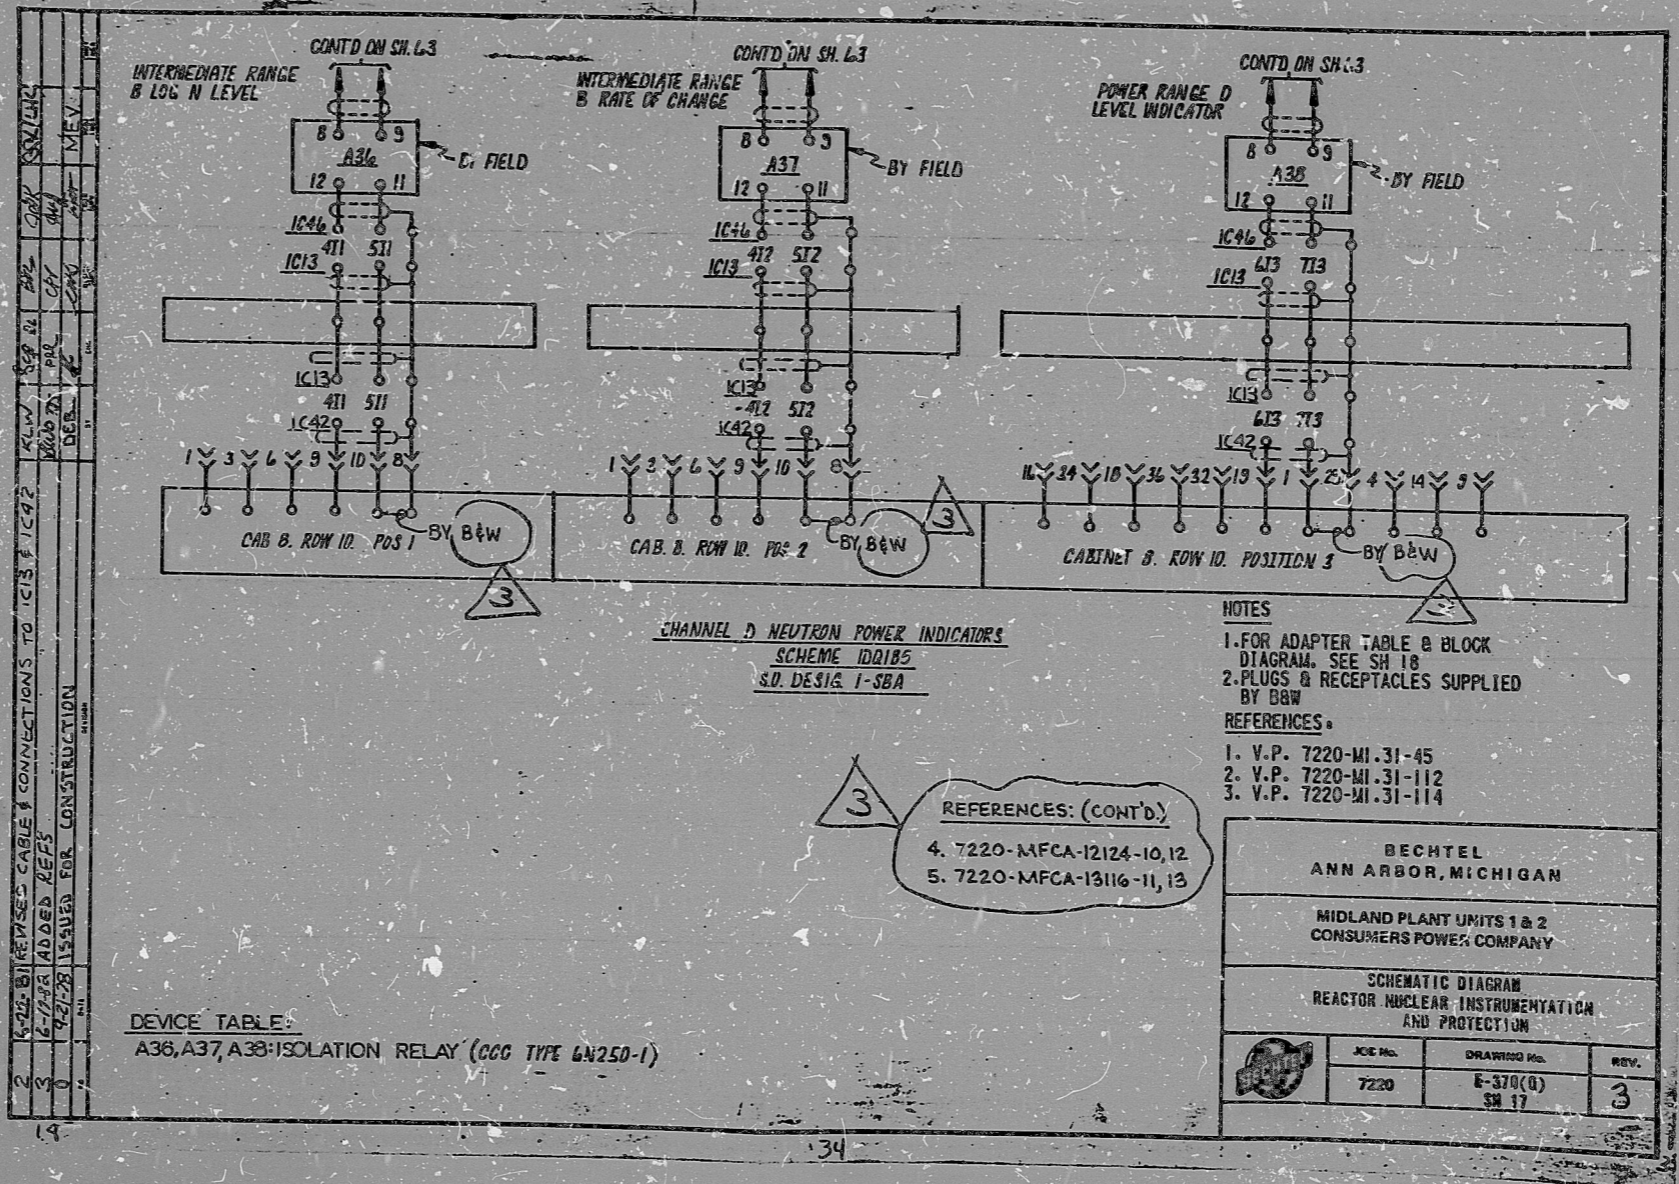

NO.	REVISIONS	DATE	BY	CHKD	APP'D

DEVICE TABLE:  
A36, A37, A38: ISOLATION RELAY (CGC TYPE 6N250-1)

CHANNEL D NEUTRON POWER INDICATORS  
SCHEME 100185  
S.D. DESIG. 1-SBA

3 REFERENCES: (CONT'D.)  
4. 7220-MFCA-12124-10, 12  
5. 7220-MFCA-13116-11, 13

- NOTES
1. FOR ADAPTER TABLE & BLOCK DIAGRAM, SEE SH 18
  2. PLUGS & RECEPTACLES SUPPLIED BY B&W
- REFERENCES
1. V.P. 7220-MI-31-45
  2. V.P. 7220-MI-31-112
  3. V.P. 7220-MI-31-114

BECHTEL ANN ARBOR, MICHIGAN		
MIDLAND PLANT UNITS 1 & 2 CONSUMERS POWER COMPANY		
SCHEMATIC DIAGRAM REACTOR NUCLEAR INSTRUMENTATION AND PROTECTION		
JOB NO. 7220	DRAWING NO. E-370(1) SH 17	REV. 3

PRO APERTURE CARD

I certify that the image contained on this frame was made in the normal and regular course of business, on the date stated below and that it is an accurate reproduction of the document submitted to reprographics.

RIDS

8302070193

