

17"

11"

8.5"

8.5"

11"

17"

17"

11"


8.5"

8.5"

11"

17"

This drawing and the design it covers are the property of BECHTEL. They are hereby loaned and on the borrower's express agreement that they will not be reproduced, copied, loaned, exhibited, or used except in the limited way and private use permitted by any written consent given by the lender to the borrower.

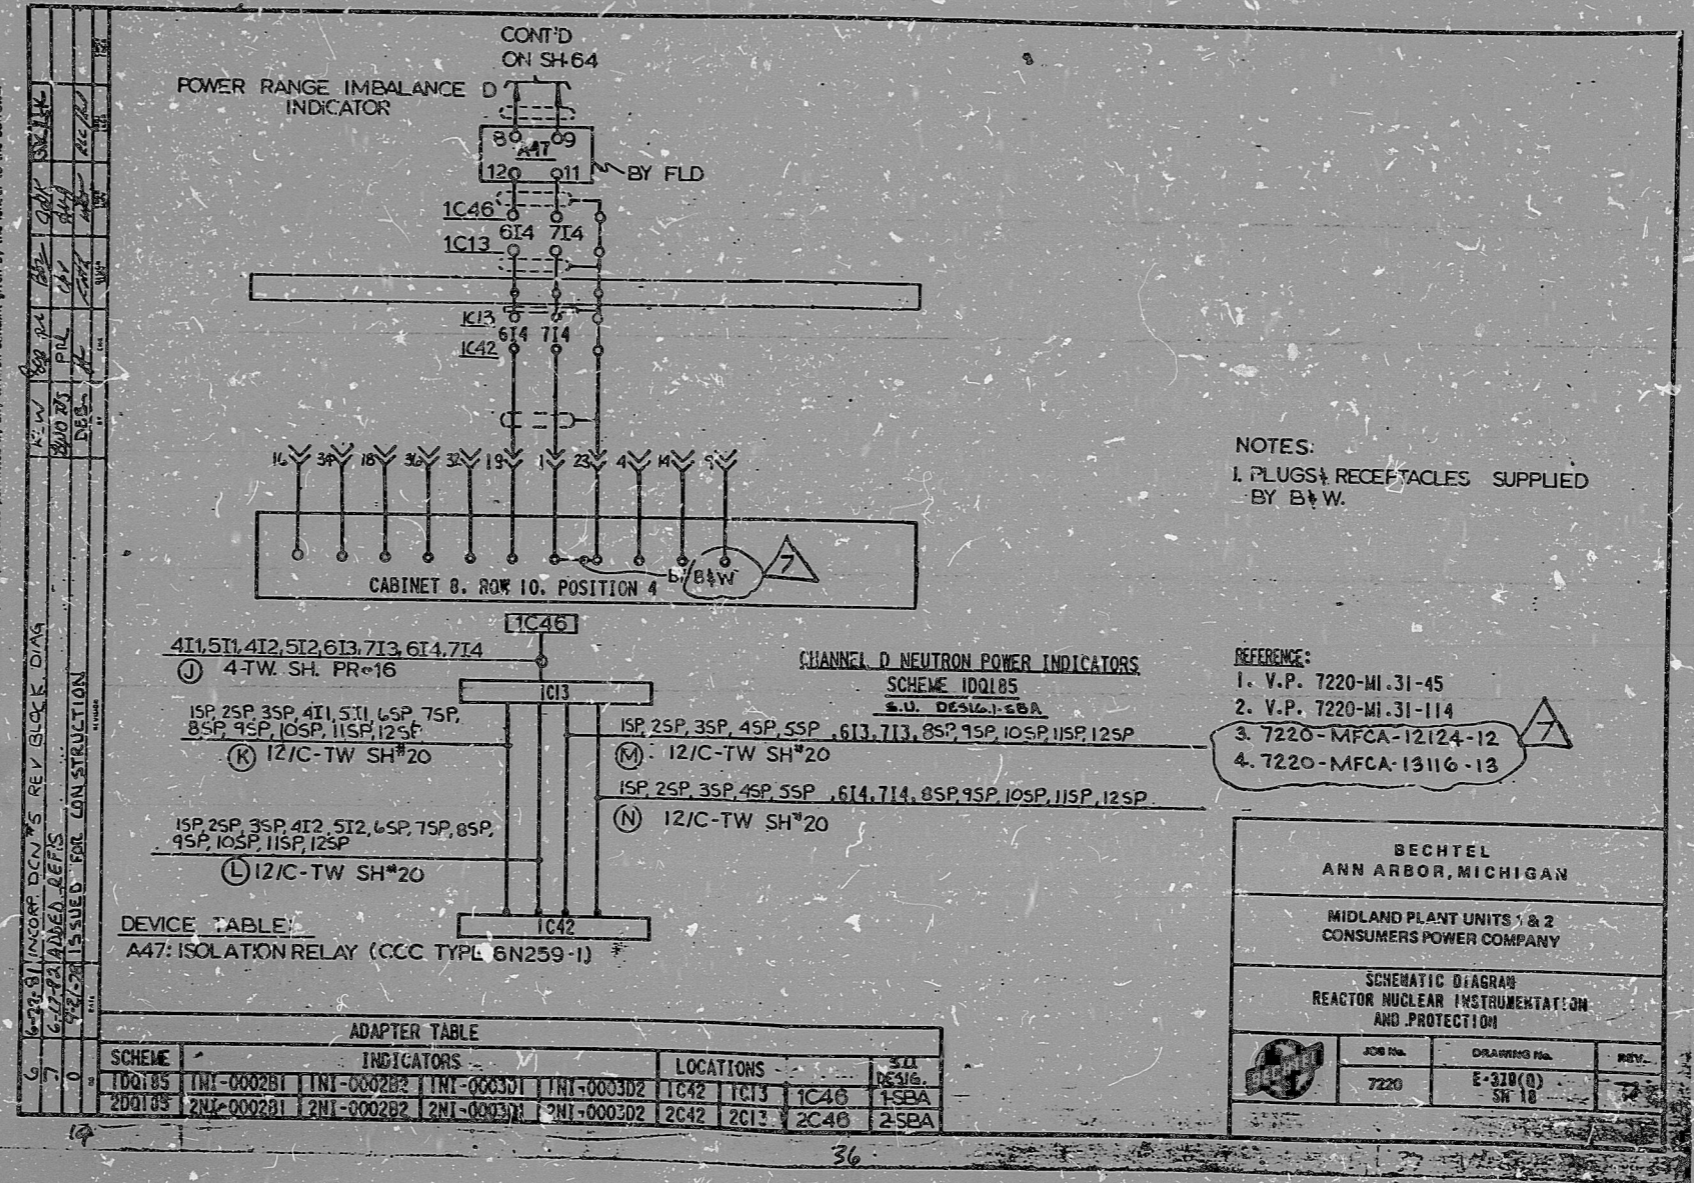

REV	NO	DATE	BY	CHK	APP

- 4I1, 5I1, 4I2, 5I2, 6I3, 7I3, 6I4, 7I4
 (1) 4-TW. SH. PR-16
 ISP, 2SP, 3SP, 4I1, 5I1, 6SP, 7SP, 8SP, 9SP, 10SP, 11SP, 12SP
 (R) 12/C-TW SH*20
 ISP, 2SP, 3SP, 4I2, 5I2, 6SP, 7SP, 8SP, 9SP, 10SP, 11SP, 12SP
 (L) 12/C-TW SH*20
 CHANNEL D NEUTRON POWER INDICATORS
 SCHEME 10Q185
 S.U. DESIGN-CBA
 ISP, 2SP, 3SP, 4SP, 5SP, 6I3, 7I3, 8SP, 9SP, 10SP, 11SP, 12SP
 (M) 12/C-TW SH*20
 ISP, 2SP, 3SP, 4SP, 5SP, 6I4, 7I4, 8SP, 9SP, 10SP, 11SP, 12SP
 (N) 12/C-TW SH*20

DEVICE TABLE
 A47: ISOLATION RELAY (CCC TYPL 6N259-1)

SCHEME	INDICATORS				LOCATIONS			SH
10Q185	1NI-000281	1NI-000282	1NI-000301	1NI-000302	1C42	1C13	1C46	1-SBA
20Q185	2NI-000281	2NI-000282	2NI-000301	2NI-000302	2C42	2C13	2C46	2-SBA

NOTES:
 1. PLUGS & RECEPTACLES SUPPLIED BY B+W.

- REFERENCE:
 1. V.P. 7220-MI-31-45
 2. V.P. 7220-MI-31-114
 3. 7220-MFCA-12124-12
 4. 7220-MFCA-13116-13

BECHTEL
 ANN ARBOR, MICHIGAN

MIDLAND PLANT UNITS 1 & 2
 CONSUMERS POWER COMPANY

SCHEMATIC DIAGRAM
 REACTOR NUCLEAR INSTRUMENTATION
 AND PROTECTION

JOB No.	DRAWING No.	REV.

PRC
 APERTURE
 CARD

I certify that the image contained on this frame was made in the normal and regular course of business, on the date stated below and that it is an accurate reproduction of the document submitted to reprographics.

RIDS

8302070195

