

17"

11"

8.5"

8.5"

11"

17"

17"

11"

8.5"

8.5"


11"

17"

This drawing and the design it covers are the property of BECHTEL. They are made, copied, used on the licensee's express agreement that they shall not be reproduced, copied, loaned, exhibited, or used except in the manner and for the purposes specifically intended by the owner in the drawings.



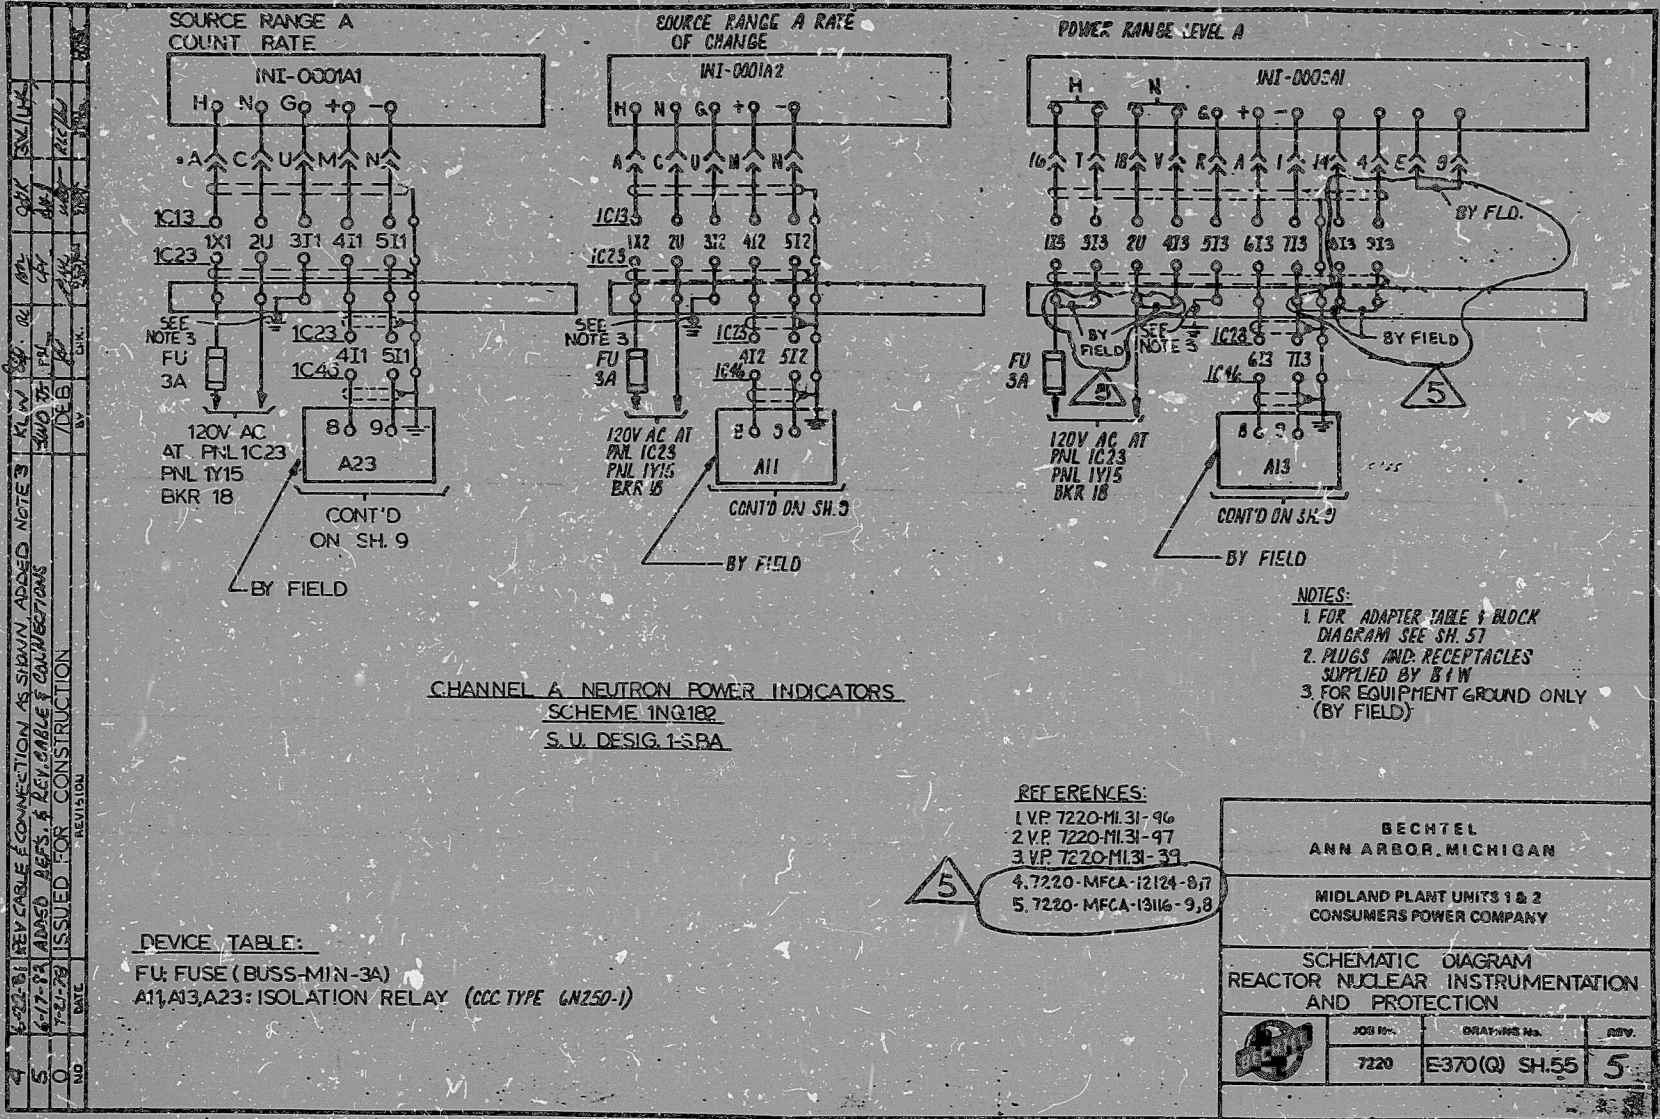

I certify that the image contained on this frame was made in the normal and regular course of business, on the date stated below and that it is an accurate reproduction of the document submitted to reprographics.

PRC
 APERTURE
 CARD

RIDS

8302070/99

