


This drawing and the design it covers are the property of BECHTEL. They are hereby loaned and on the borrower's express agreement, that they will not be reproduced, copied, leased, exhibited, or used (except in the form and for the purpose permitted by any written consent given by the lender to the borrower).

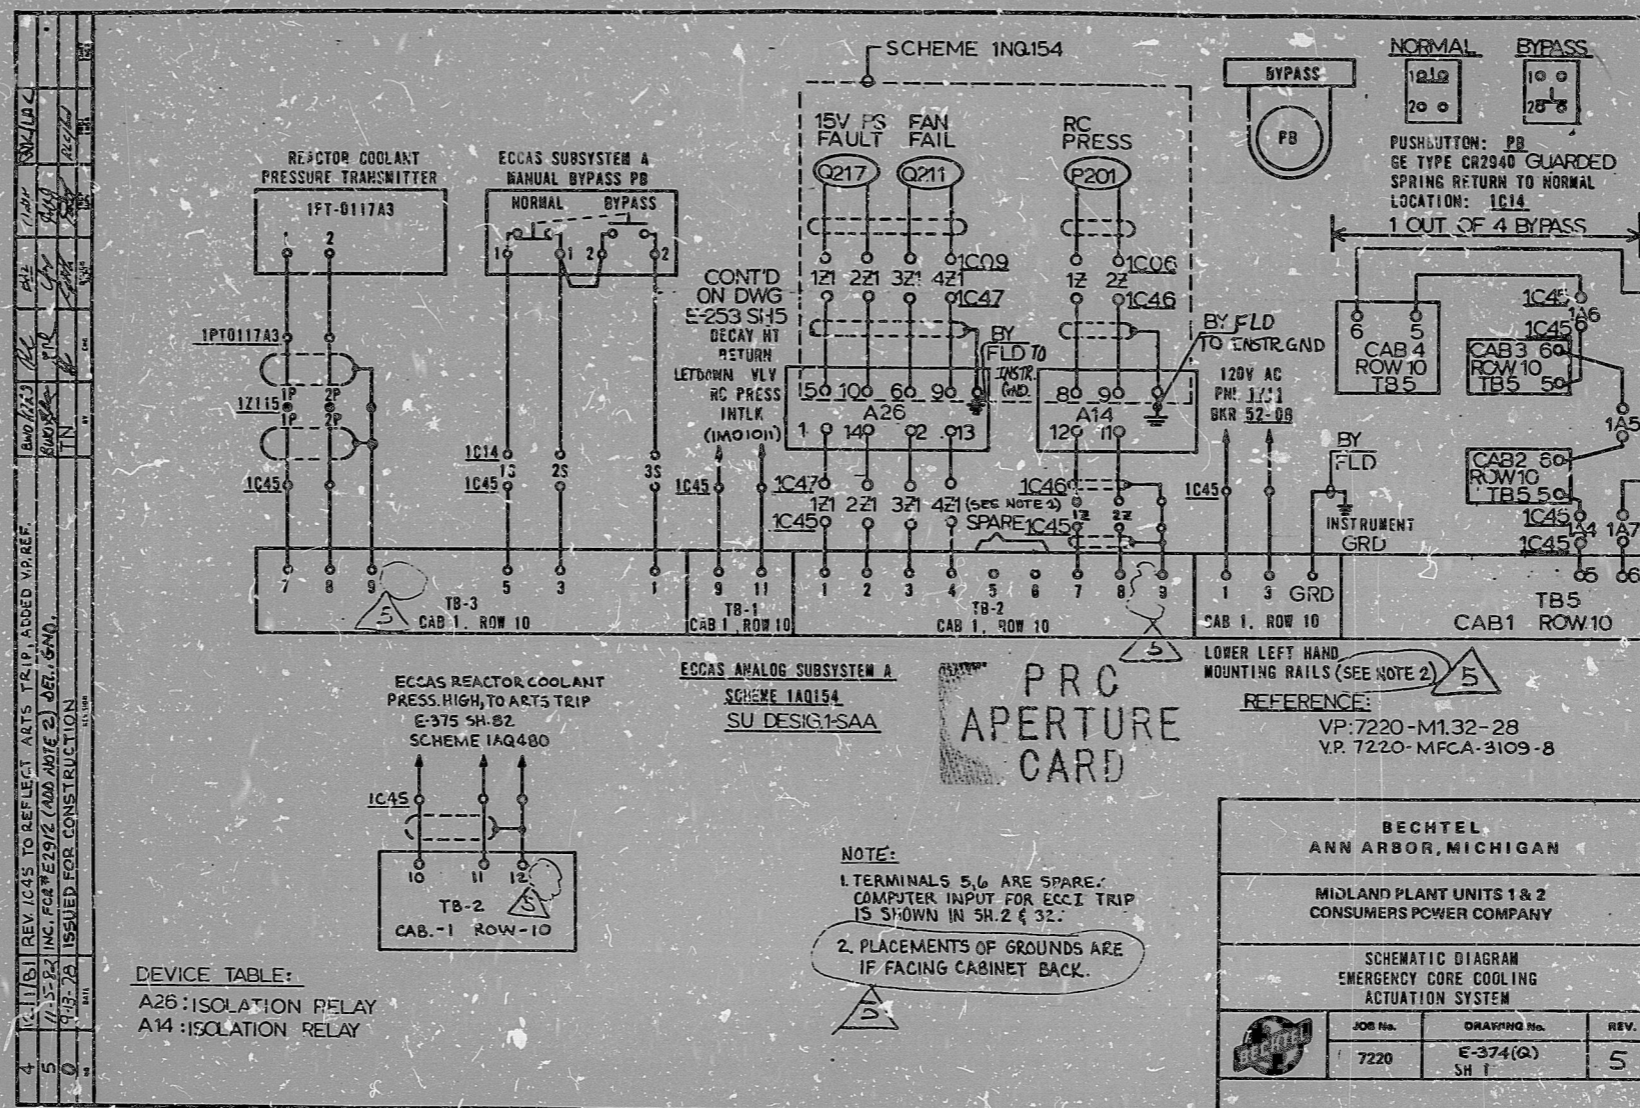

**4-6-X**

**CERTIFICATE OF MICROFILMING**

"I certify that the image contained on this frame was made in the normal and regular course of business on the date stated below and that it is an accurate reproduction of the document submitted to the contractor for filming by Bechtel Power Corporation."

DATE: 11-28-82  
CAMERA OPERATOR: *Carol DeWitt*  
CONTRACTOR SUPERVISOR: *Susan Crockett*

RID's

8302090026

