


17
11
8.5
8.5
11
17

17
11
8.5
8.5
11
17

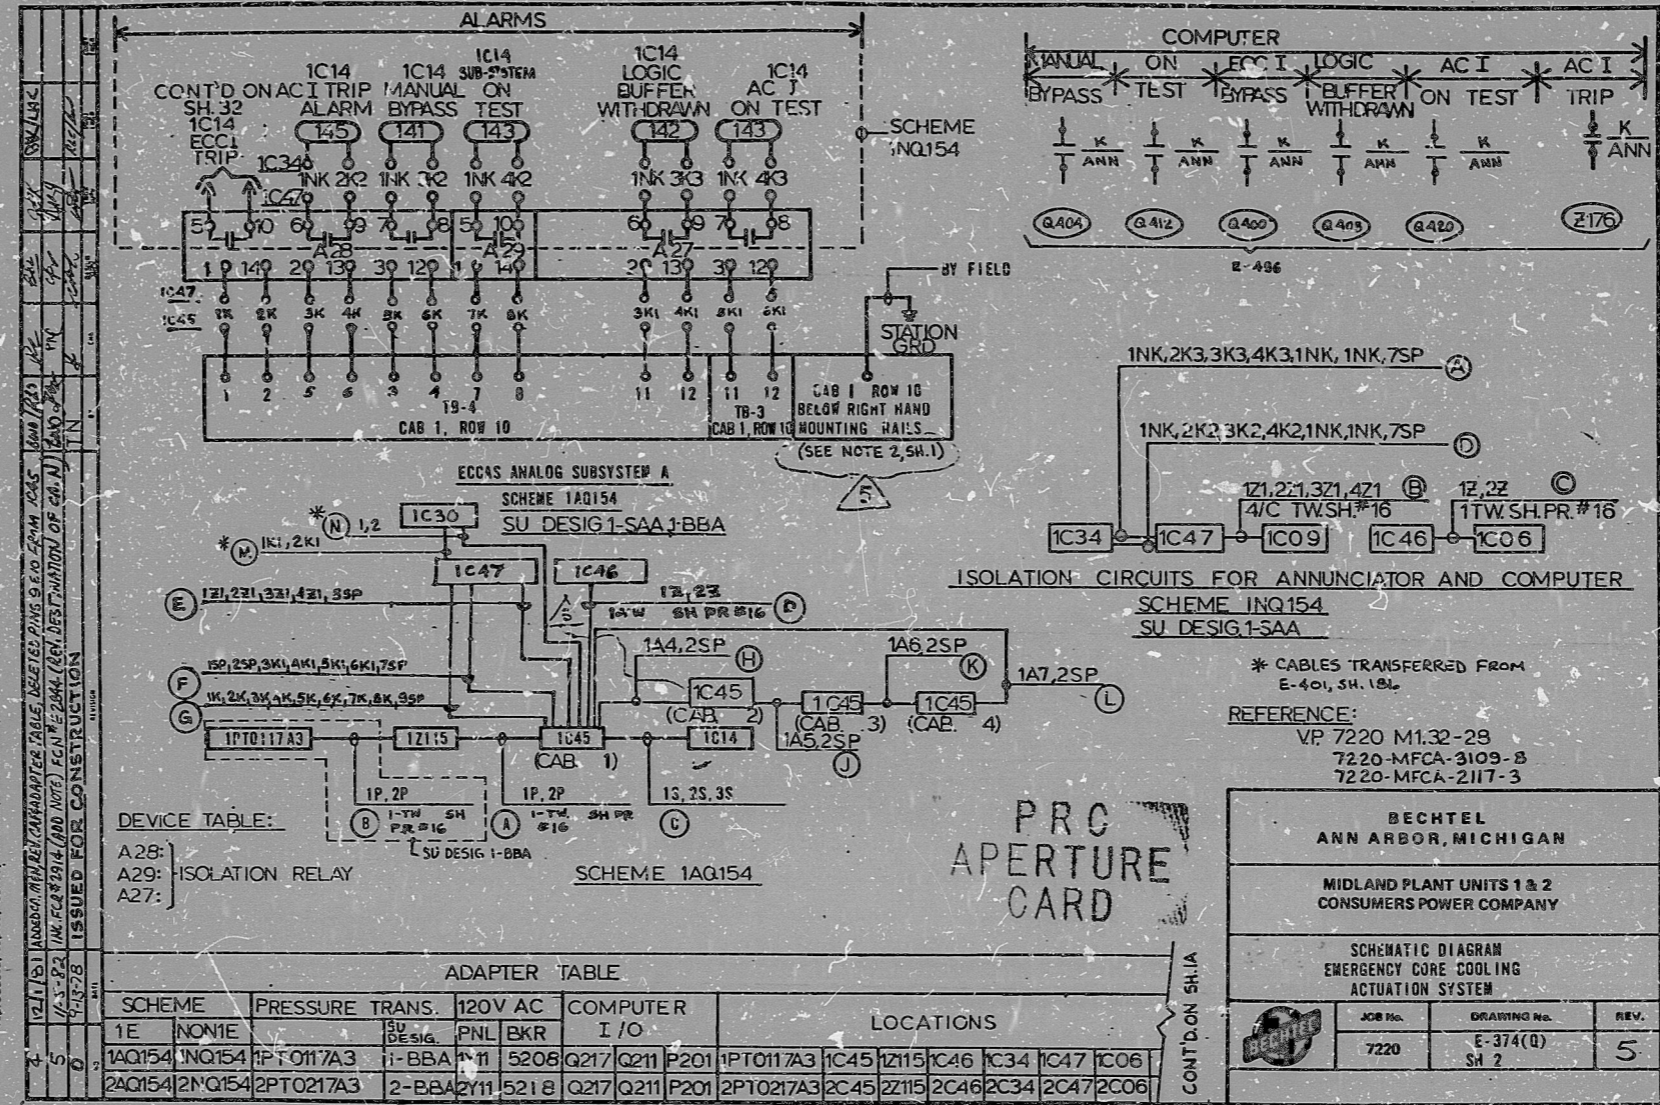

16X

CERTIFICATE OF MICROFILMING

"I certify that the image contained on this frame was made in the normal and regular course of business on the date stated below and that it is an accurate reproduction of the document submitted to the contractor for filming by Bechtel Power Corporation."

11-28-82 DATE
Camera Operator
Susan Crockett
CONTRACTOR SUPVSR.

RIDS

8302090028

