

17"


11"

8.5"

17"

11"


8.5"

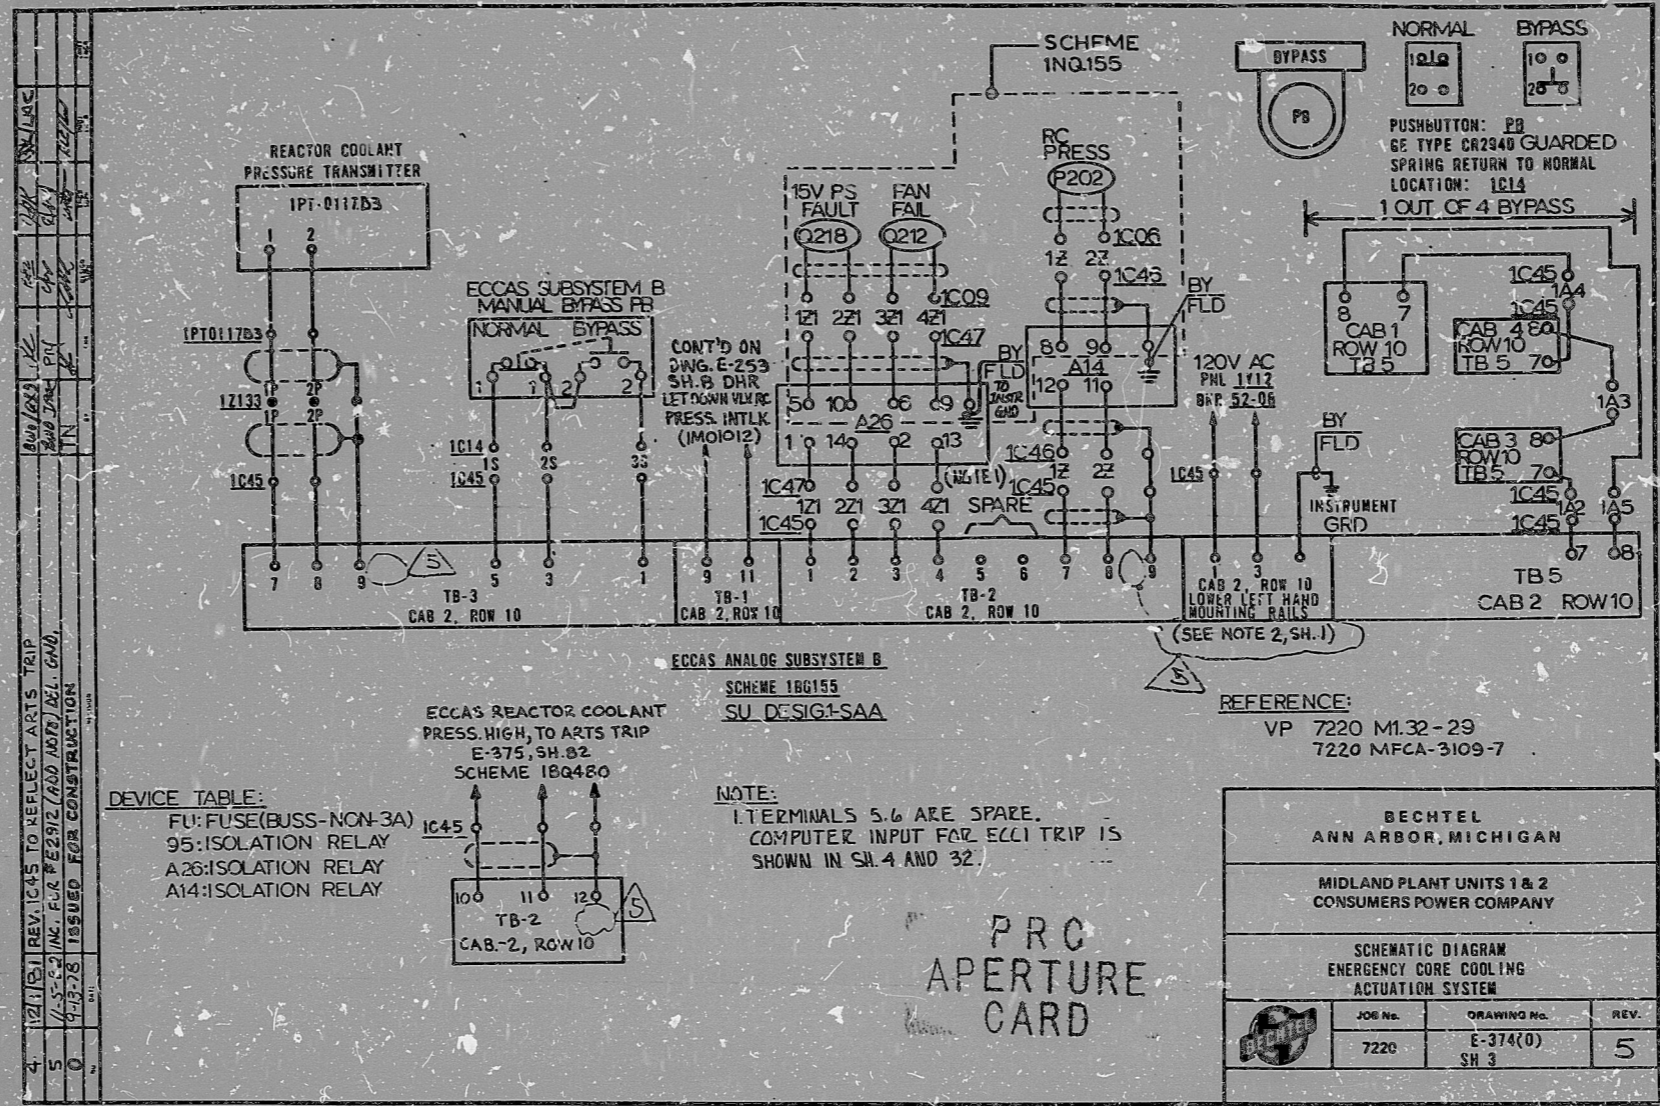

This drawing and the design it covers are the property of BECHTEL. They are hereby loaned and on the borrower's express agreement that they will not be reproduced, copied, loaned, retransmitted, or used except in the limited way and phrase as permitted by any written consent given by the lender to the borrower.

REV.	DATE	BY	CHKD.	APP.	REASON
4	12/11/51	REV. 1, 2, 3 TO REFLECT ARTS TRIP			
5	1/15/52	INC. FOR P202 (ADD 1A3) DEL. 1A4			
0	4/25/78	ISSUED FOR CONSTRUCTION			

DEVICE TABLE:
FU: FUSE (BUSS-NON-3A)
95: ISOLATION RELAY
A26: ISOLATION RELAY
A14: ISOLATION RELAY

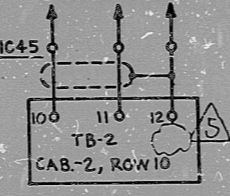

NOTE:
1. TERMINALS 5, 6 ARE SPARE.
COMPUTER INPUT FOR ECCI TRIP IS SHOWN IN SH. 4 AND 32.

PRO APERTURE CARD

1-6 X

CERTIFICATE OF MICROFILMING

"I certify that the image contained on this frame was made in the normal and regular course of business on the date stated below and that it is an accurate reproduction of the document submitted to the contractor for filming by Bechtel Power Corporation."

11-2882 *Caren DeHaven Susan Crockett*
DATE CAMERA OPERATOR CONTRACTOR SUPERVISOR

8.5"

11"

17"

8.5"

11"

17"

RIDS

8302090031

