

17

11

8.5

8.5

11

17

17


11

8.5

8.5

11

17

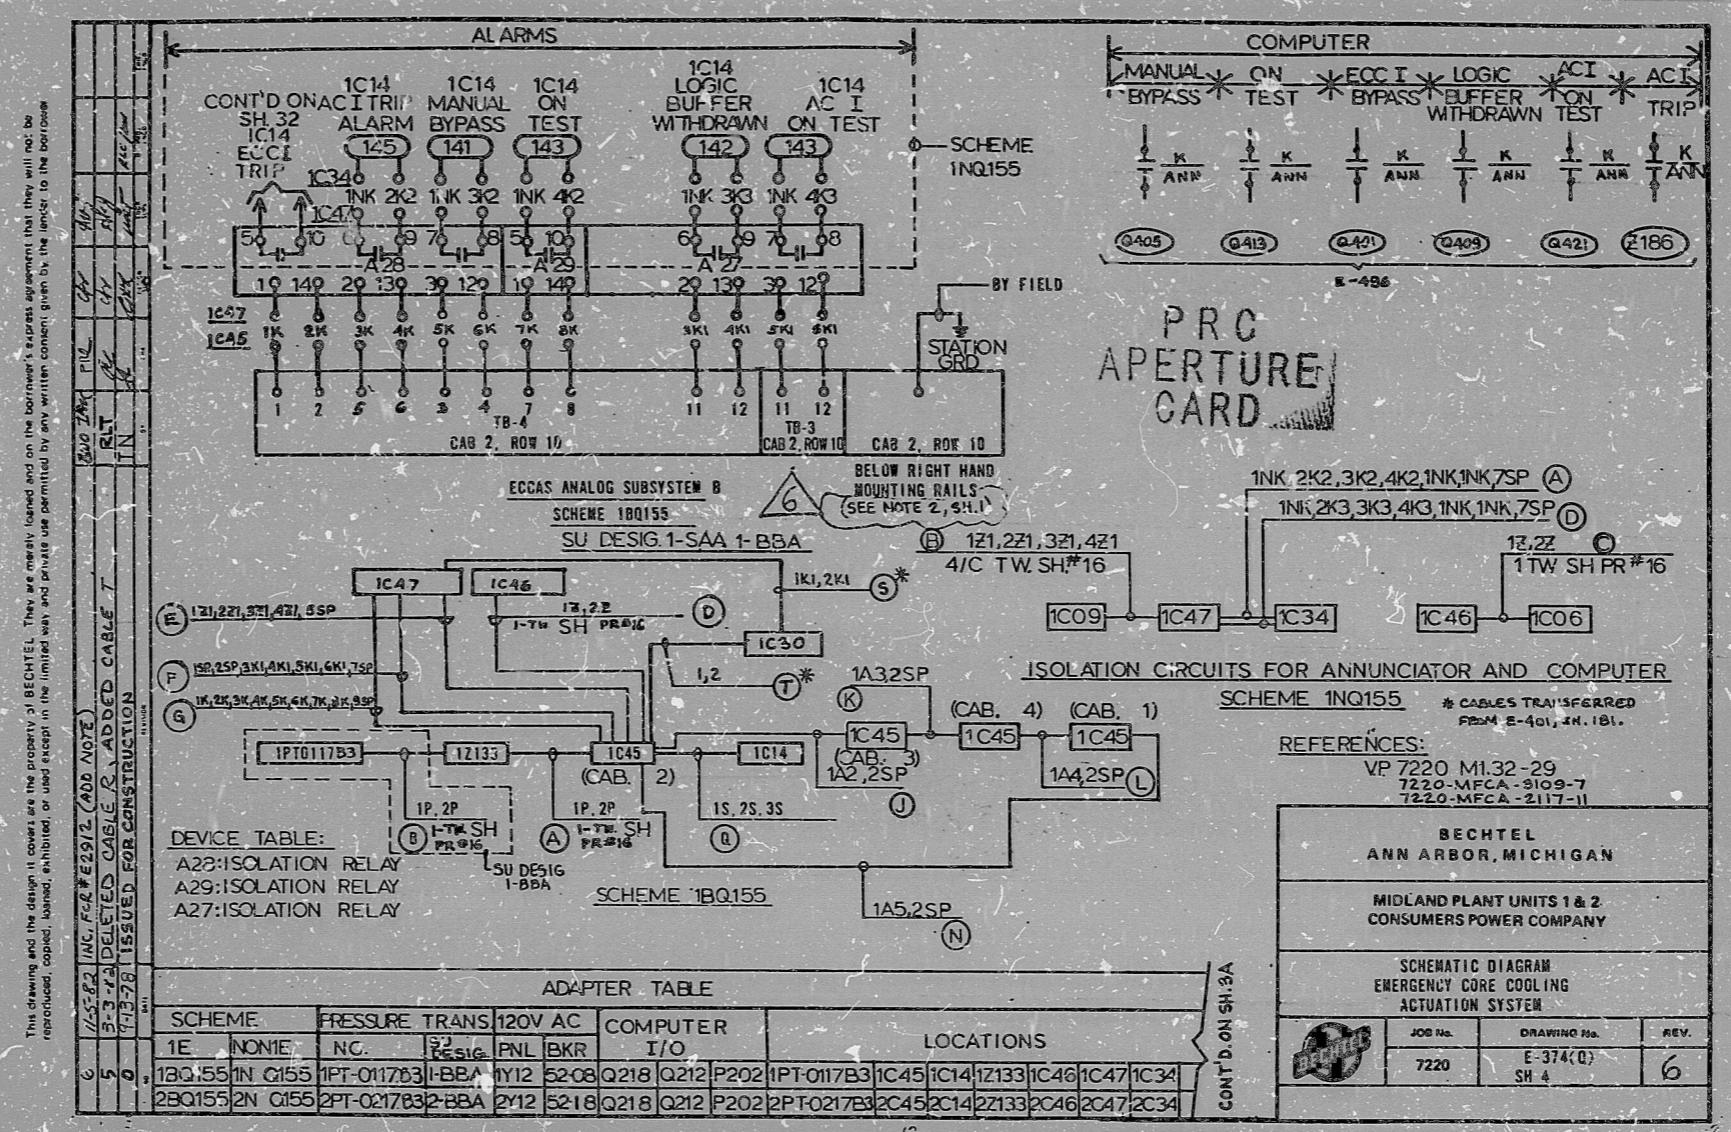

1-6 X

CERTIFICATE OF MICROFILMING

"I certify that the image contained on this frame was made in the normal and regular course of business on the date stated below and that it is an accurate reproduction of the document submitted to the contractor for filming by Bechtel Power Corporation."

11-28-82 *Caron DeSain* *Susan Crockett*  
DATE CAMERA OPERATOR CONTRACTOR SUPRVSR.



RIDS

8392090032

