

17"

11"

8.5"


17"

11"

8.5"

This drawing and the design it covers are the property of BECHTEL. They are hereby loaned and on the borrower's express agreement that they will not be reproduced, copied, loaned, exhibited, or used in any way without the written consent given by the lender to the borrower.

1	12/11/72	REVISED	1	12/11/72	REVISED
2	1/15/73	ISSUED FOR CONSTRUCTION	2	1/15/73	ISSUED FOR CONSTRUCTION
3	1/15/73	ISSUED FOR CONSTRUCTION	3	1/15/73	ISSUED FOR CONSTRUCTION
4	1/15/73	ISSUED FOR CONSTRUCTION	4	1/15/73	ISSUED FOR CONSTRUCTION

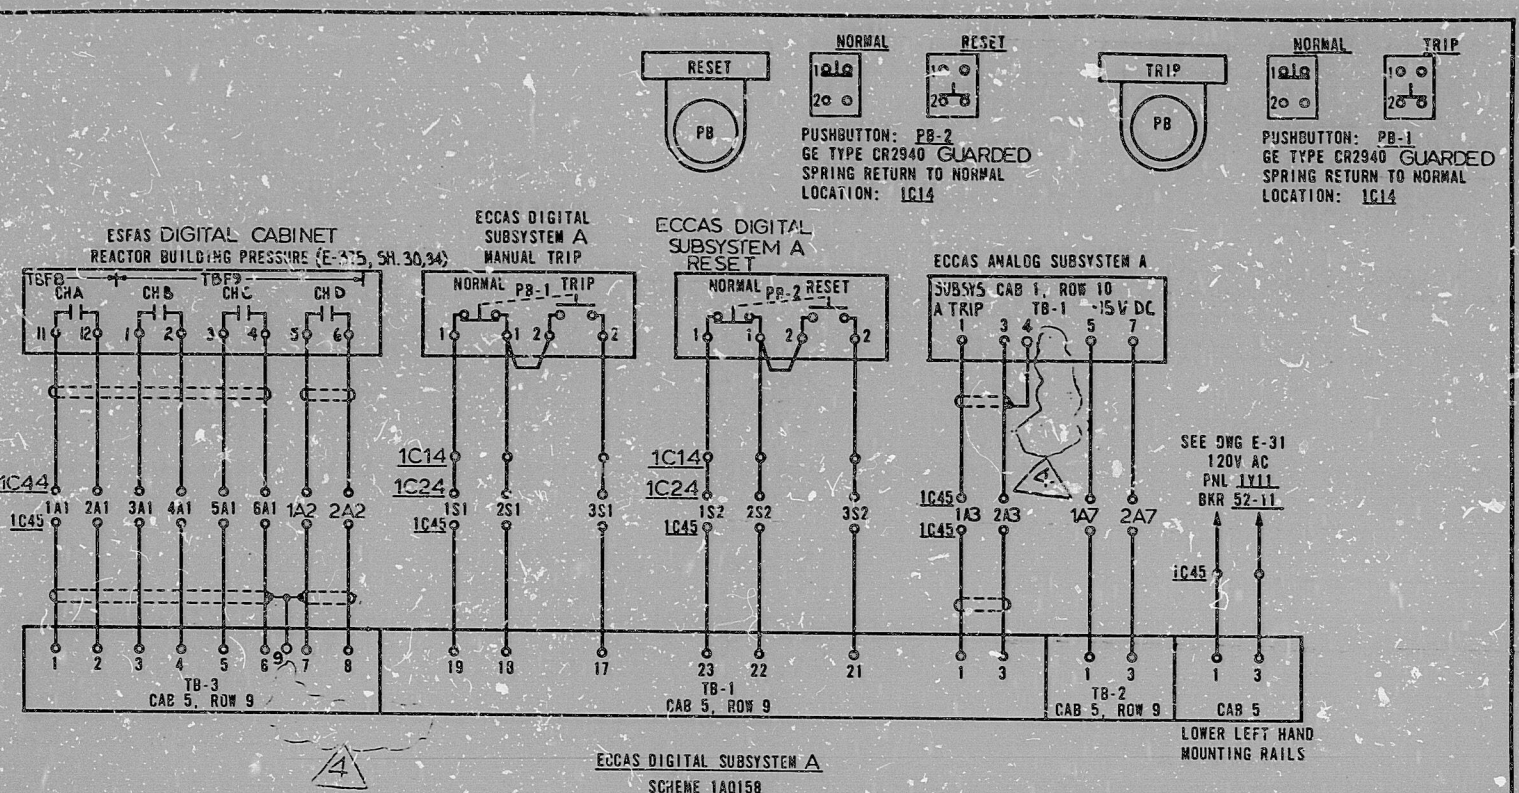

ECCAS DIGITAL SUBSYSTEM A
 SCHEME 1AQ158
 S.U. DESIG. 1-SAA REFERENCE:
 VP: 7220-M1.32-32

PRC
 APERTURE
 CARD

BECHTEL ANN ARBOR, MICHIGAN		
MIDLAND PLANT UNITS 1 & 2 CONSUMERS POWER COMPANY		
SCHEMATIC DIAGRAM EMERGENCY CORE COOLING ACTUATION SYSTEM		
JOB No. 7220	DRAWING No. E-374(G) SH 9	REV. 4

CERTIFICATE OF MICROFILMING

"I certify that the image contained on this frame was made in the normal and regular course of business on the date stated below and that it is an accurate reproduction of the document submitted to the contractor for filming by Bechtel Power Corporation."
 DATE 11-23-72 CAMERA OPERATOR *Caron* CONTRACTOR SUPERVISOR *Susan Crockett*

16X

8.5"

11"

8.5"

11"

17"

17"

RIDS

8302090043

