


17
11
8.5
8.5
11
17

17
11
8.5
8.5
11
17

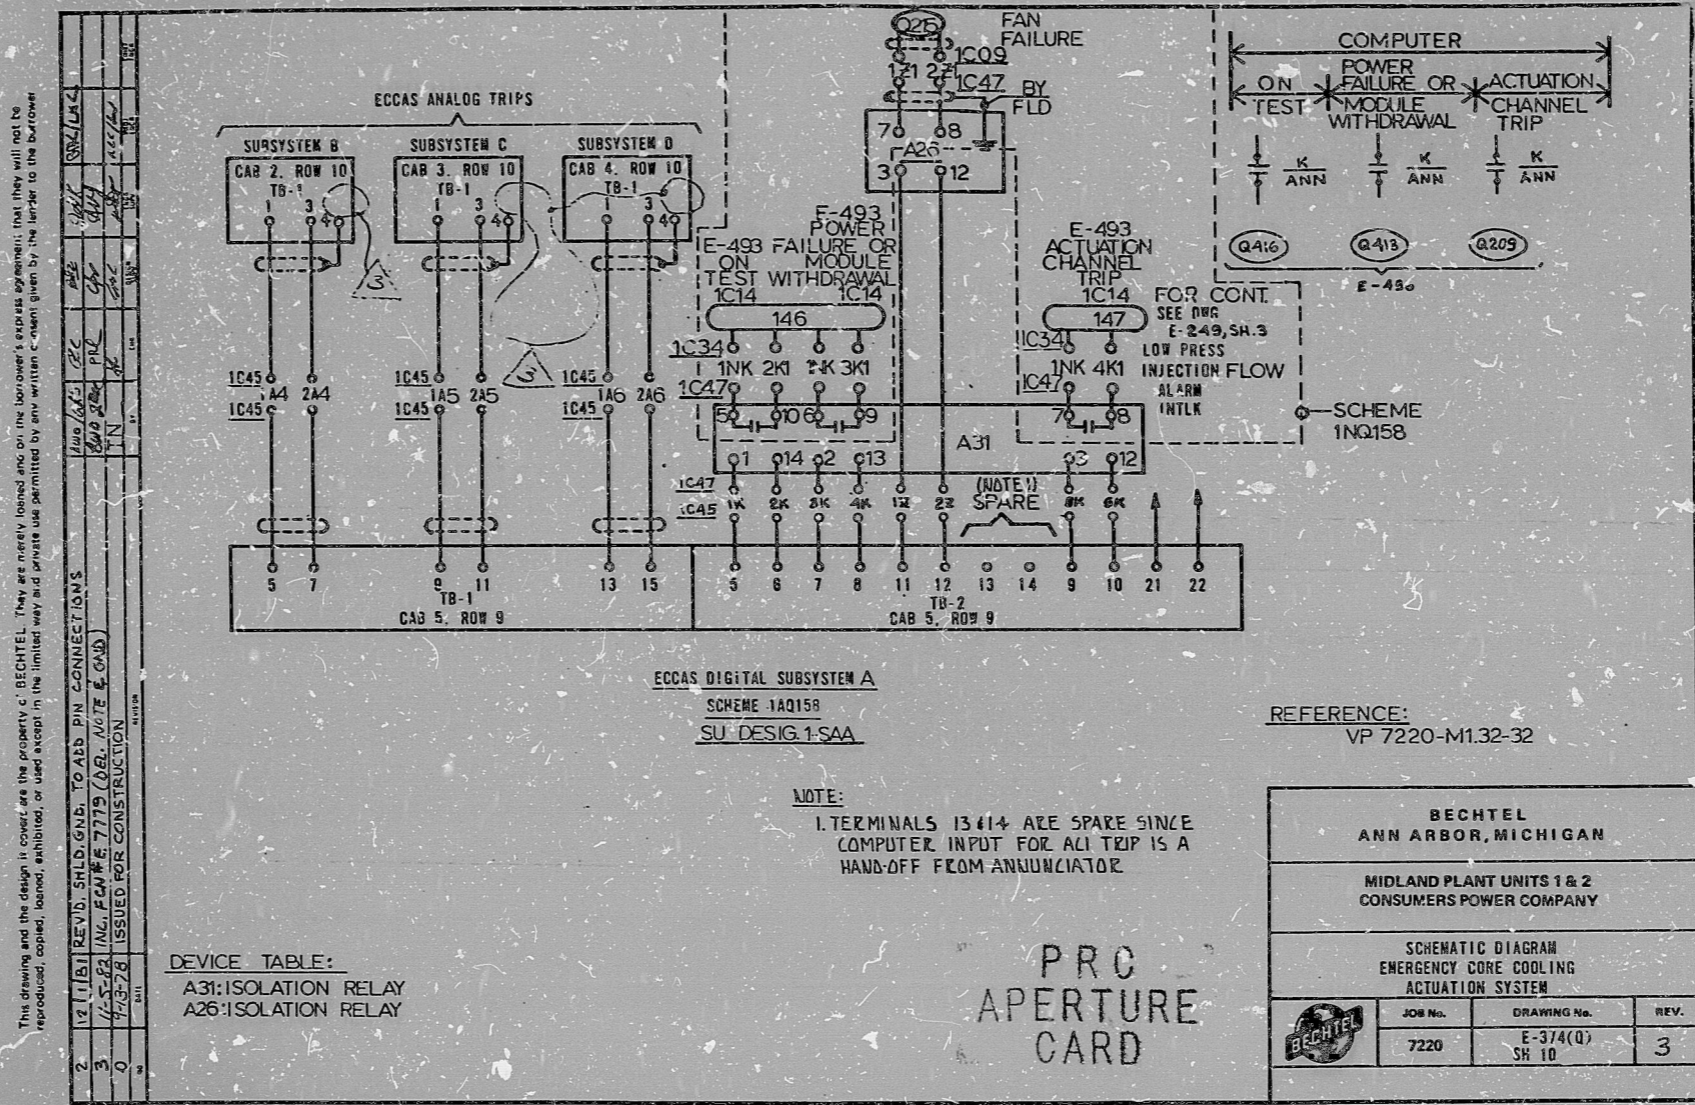

This drawing and the design it covers are the property of BECHTEL. They are hereby loaned and on the borrower's express agreement that they will not be reproduced, copied, loaned, exhibited, or used except in the limited way and private use permitted by any written consent given by the lender to the borrower.

REV.	DATE	BY	CHKD.	DESCRIPTION

DEVICE TABLE:
A31: ISOLATION RELAY
A26: ISOLATION RELAY

PRO
APERTURE
CARD

16X

CERTIFICATE OF MICROFILMING

I certify that the image contained on this frame was made in the normal and regular course of business on the date stated below and that it is an accurate reproduction of the document submitted to the contractor for filming by Bechtel Power Corporation.

11-23-72 *Conan* *Swain*
DATE CAMERA OPERATOR CONTRACTOR SUPERVISOR

RIDS

8302090045

