


17"
11"
8.5"
8.5"
11"
17"

17"
11"
8.5"
8.5"
11"
17"

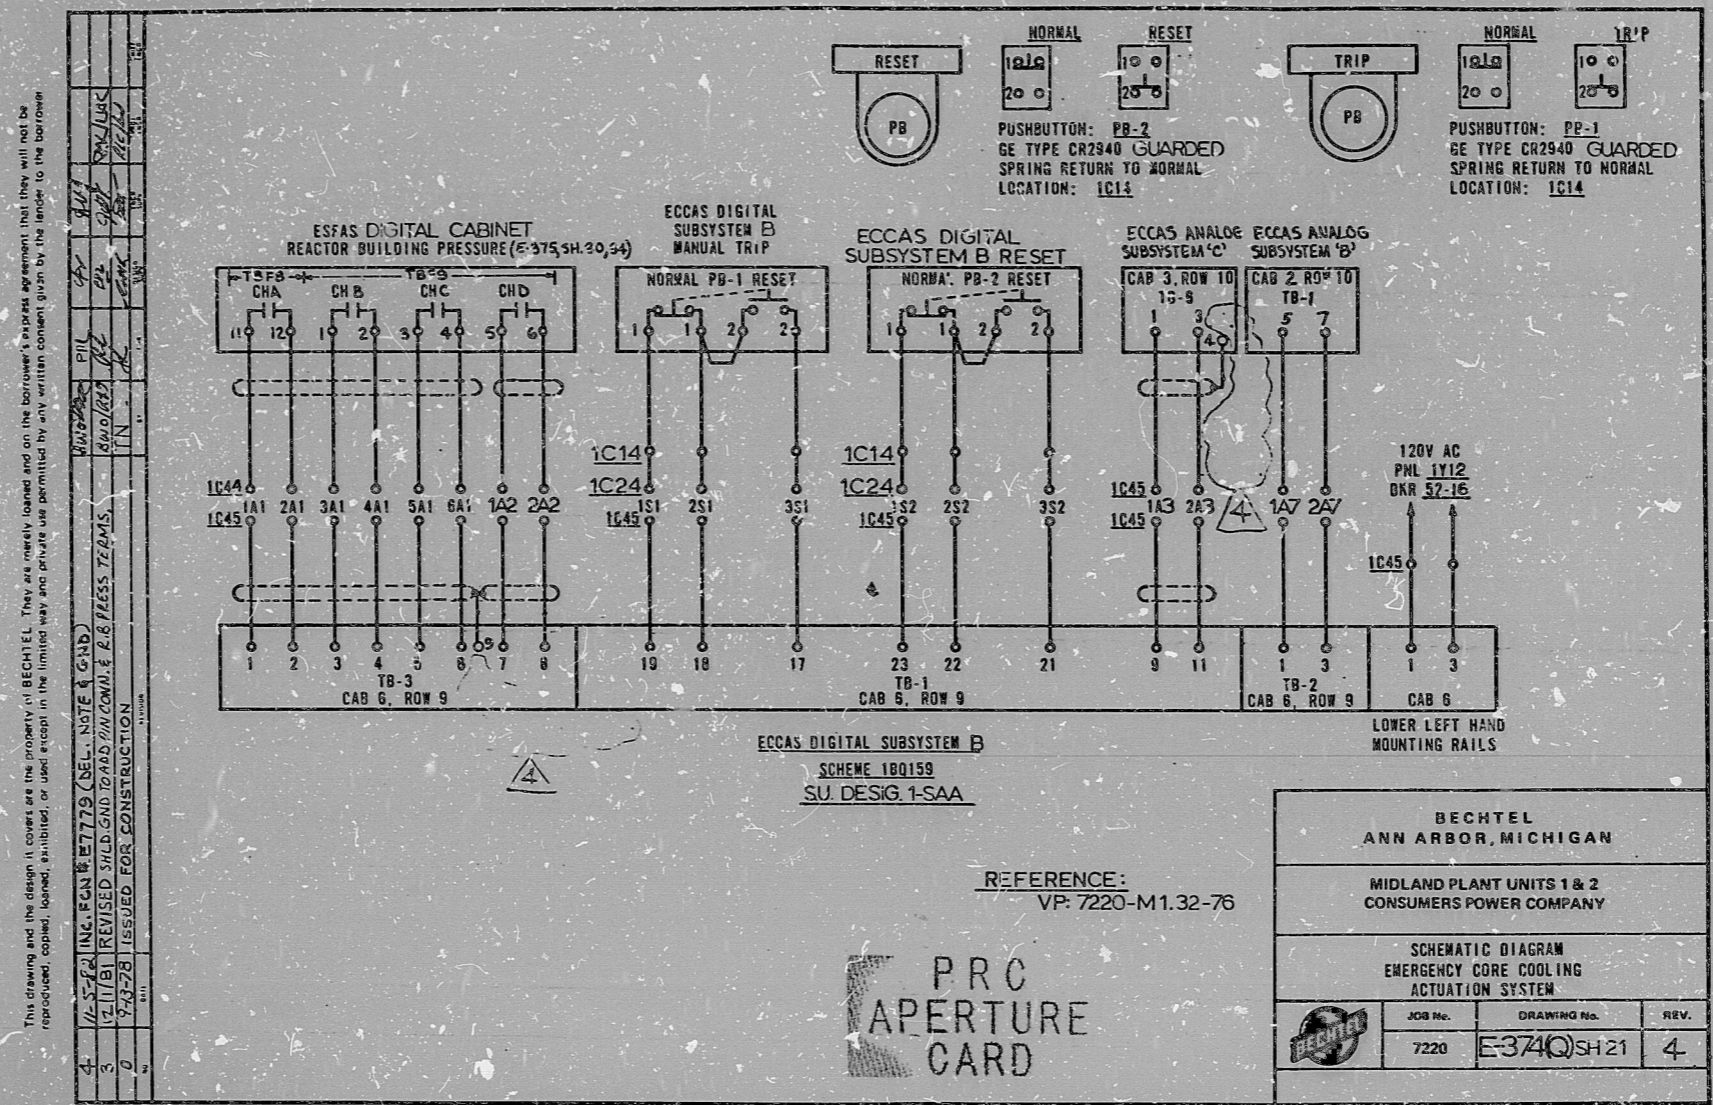

16X

CERTIFICATE OF MICROFILMING

"I certify that the image contained on this frame was made in the normal and regular course of business on the date stated below and that it is an accurate reproduction of the document submitted to the contractor for filming by Bechtel Power Corporation."

11-23-72 *Carol DeFina* *Susan Crockett*
DATE CAMERA OPERATOR CONTRACTOR SUPERVISOR

RIDS

8302090053

