

17"

11"

8.5"

8.5"

11"

17"

17"


11"

8.5"

8.5"

11"

17"

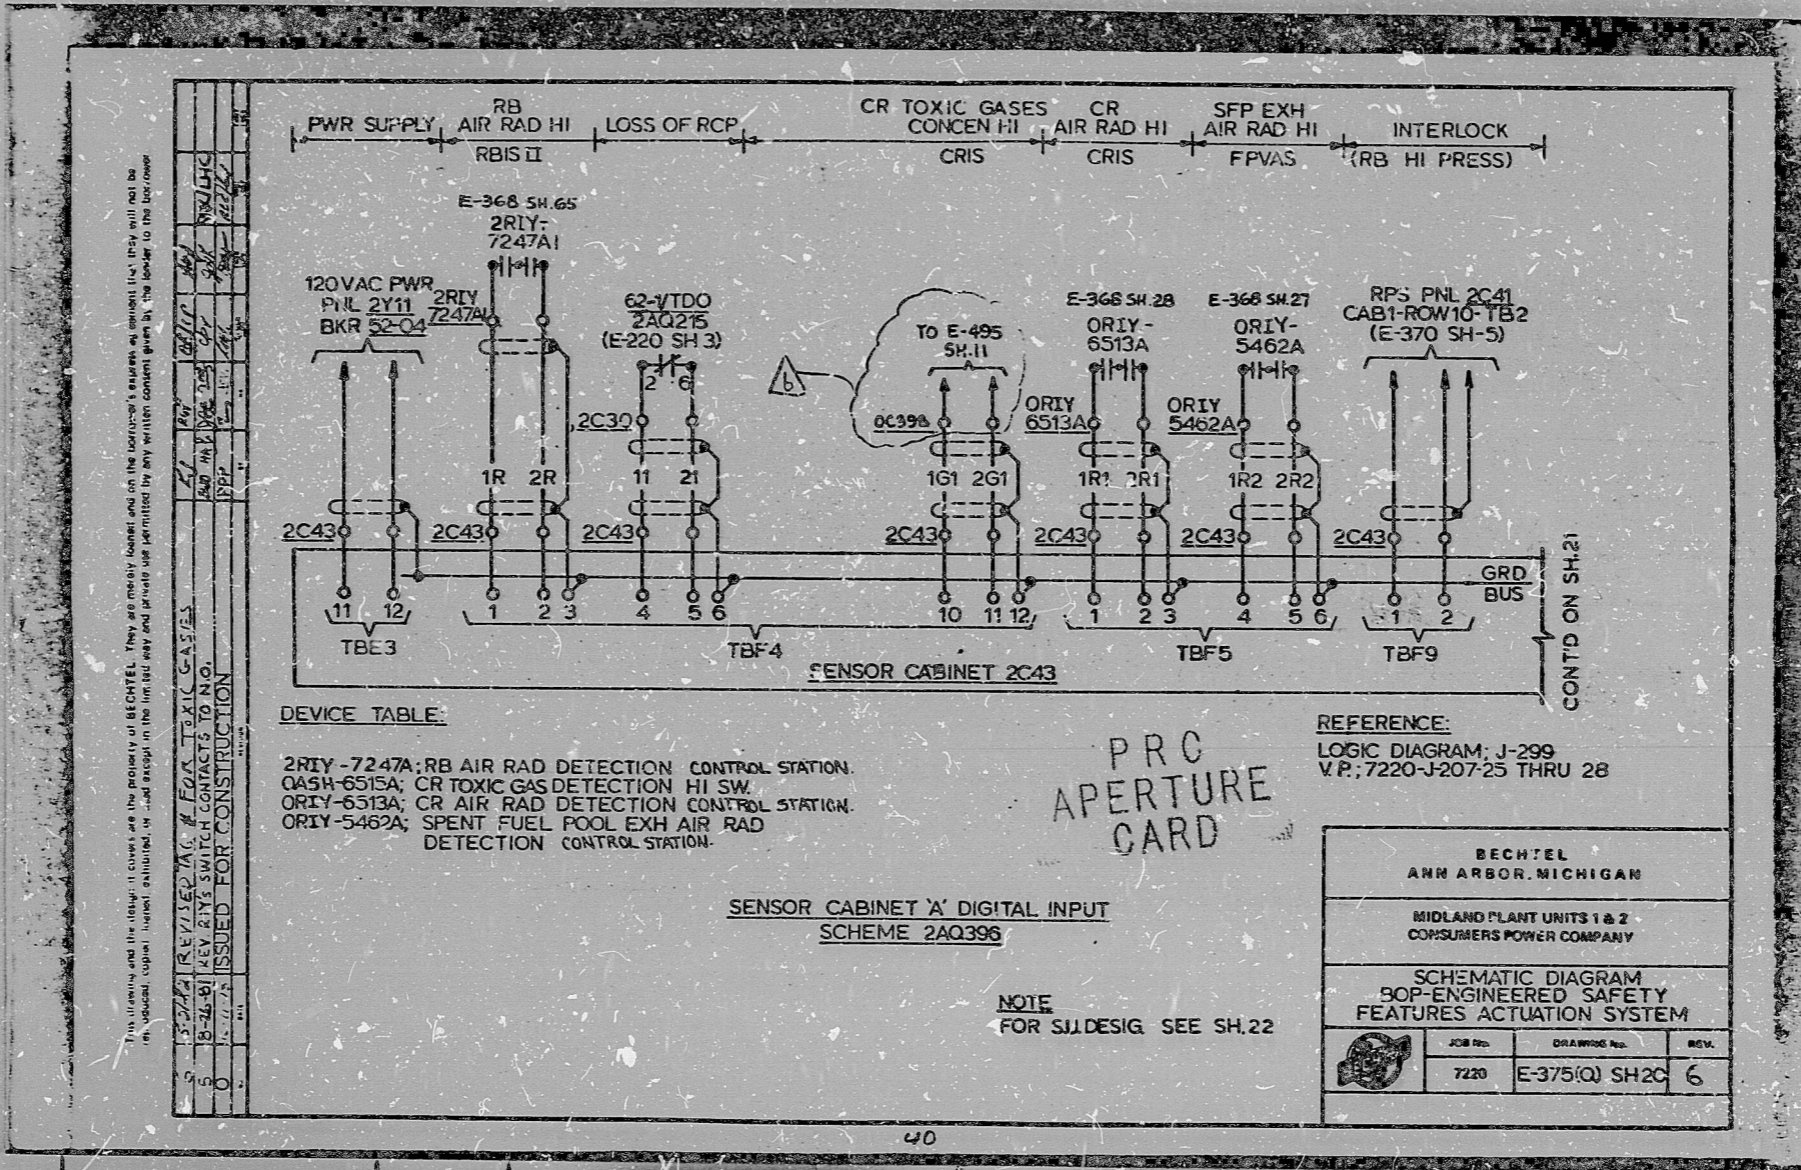

This drawing and the information contained hereon are the property of BECHTEL. They are hereby loaned and on the borrower's request as shown. If they will not be returned, the borrower shall be held responsible for their return. All copies of this drawing are to be made from the original.

157242 REVISED TAG # FOR TOXIC GASES
 18-24-81 REV. AIRS SWITCH CONTACTS TO NO.
 11-11-75 ISSUED FOR CONSTRUCTION

16X

CERTIFICATE OF MICROFILMING

"I certify that the image contained on this frame was made in the normal and regular course of business, on the date stated below and that it is an accurate reproduction of the document submitted to the contractor for filming, by Bechtel Power Corporation".

DATE: 9-29-82
 CAMERA OPERATOR: Rose Spies
 CONTRACTOR SUPERVISOR: Sue Crockett

RIDS

8302090063

