

17"

11"

8.5"

8.5"

11"

17"

17"

11"


8.5"

8.5"

11"

17"

This drawing and the design it covers are the property of BECHTEL. They are hereby loaned and on the borrower's express agreement that they will not be reproduced, copied, loaned, exhibited, or used except in the limited way and precise use permitted by the issuer to the borrower.  
 7220-115  
 INC. PLAN TOSSB (AN. TERM. NO.)  
 3 3-5-82 ADDED TERM. NOS. BY BLOCK DIAG. & CABLE P. WIRE. M. 2/2/82  
 11-A-83 ISSUED FOR CONSTRUCTION

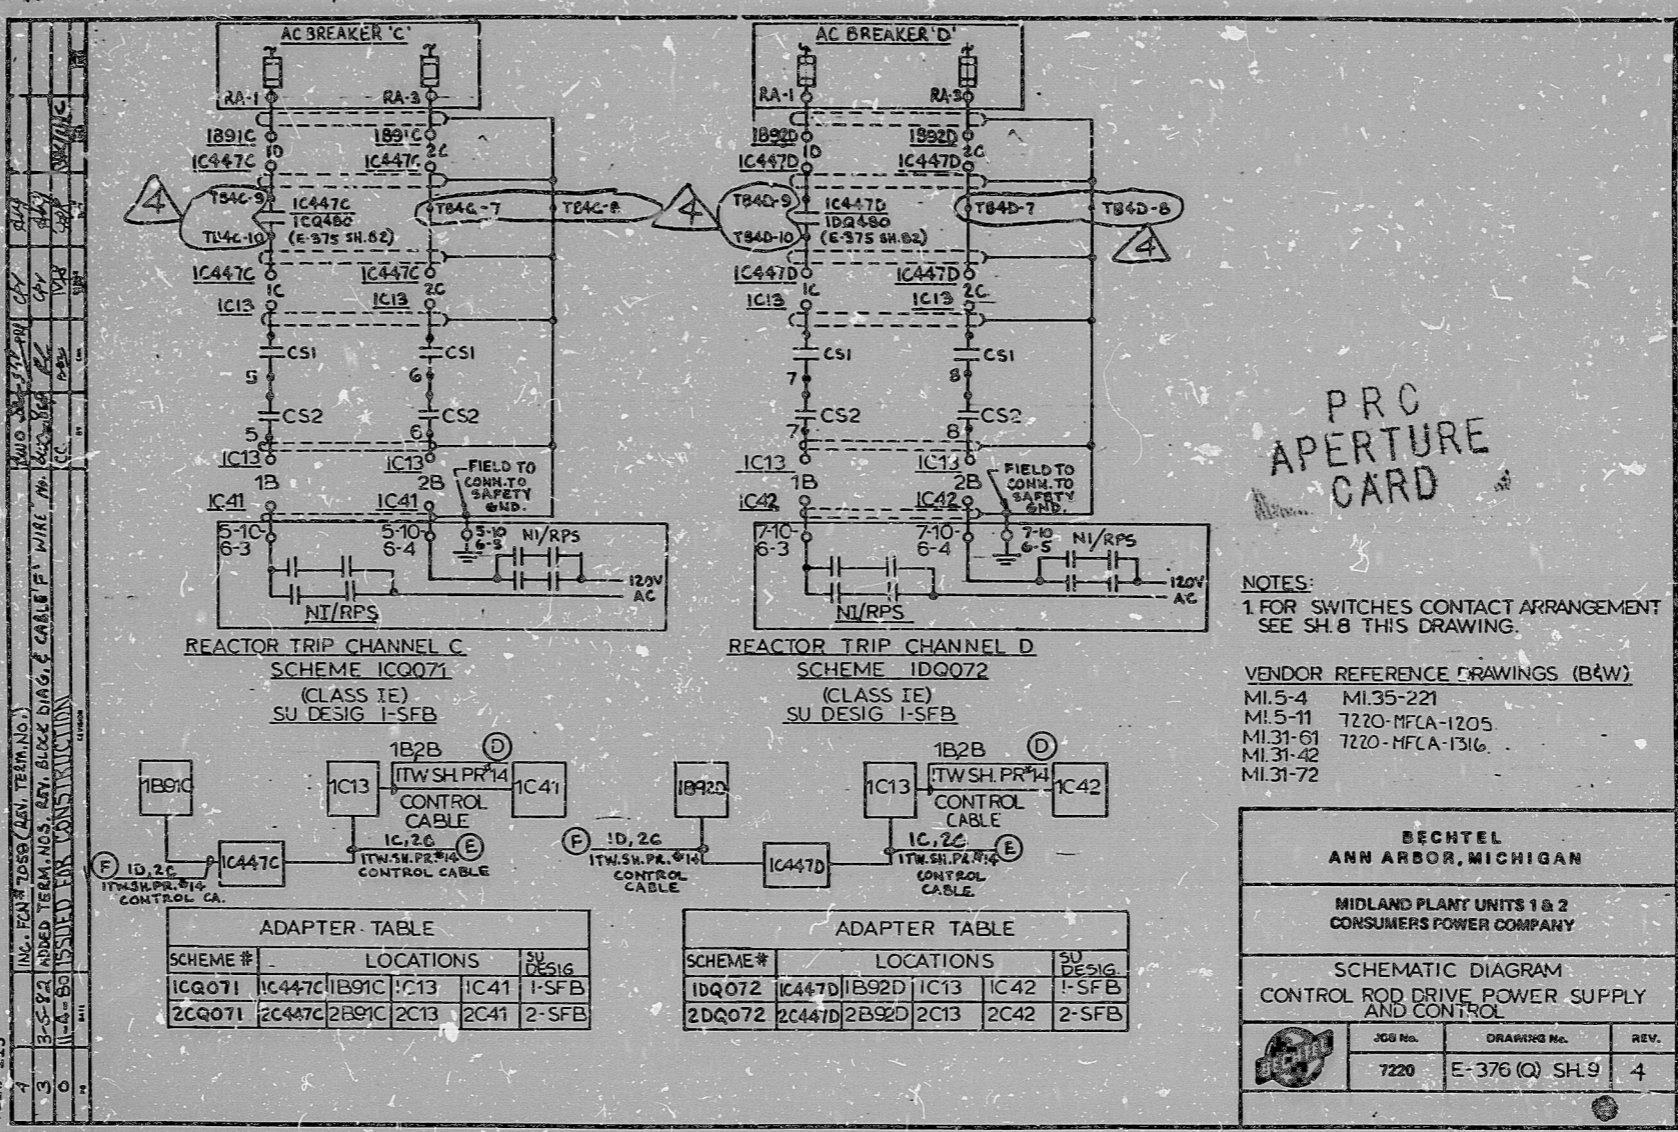

PRO APERTURE CARD

16X

CERTIFICATE OF MICROFILMING  
 "I certify that the image contained on this frame was made in the normal and regular course of business, on the date stated below and that it is an accurate reproduction of the document submitted to the contractor for filming, by Bechtel Power Corporation."  
 DATE 10-20-82 PAM Smith  
 CAMERA OPERATOR Sue Crockett  
 CONTRACTOR SUPERVISOR

RIDS

8302090096

