


17"
11"
8.5"
11"
8.5"
17"

17"
11"
8.5"
11"
8.5"
17"

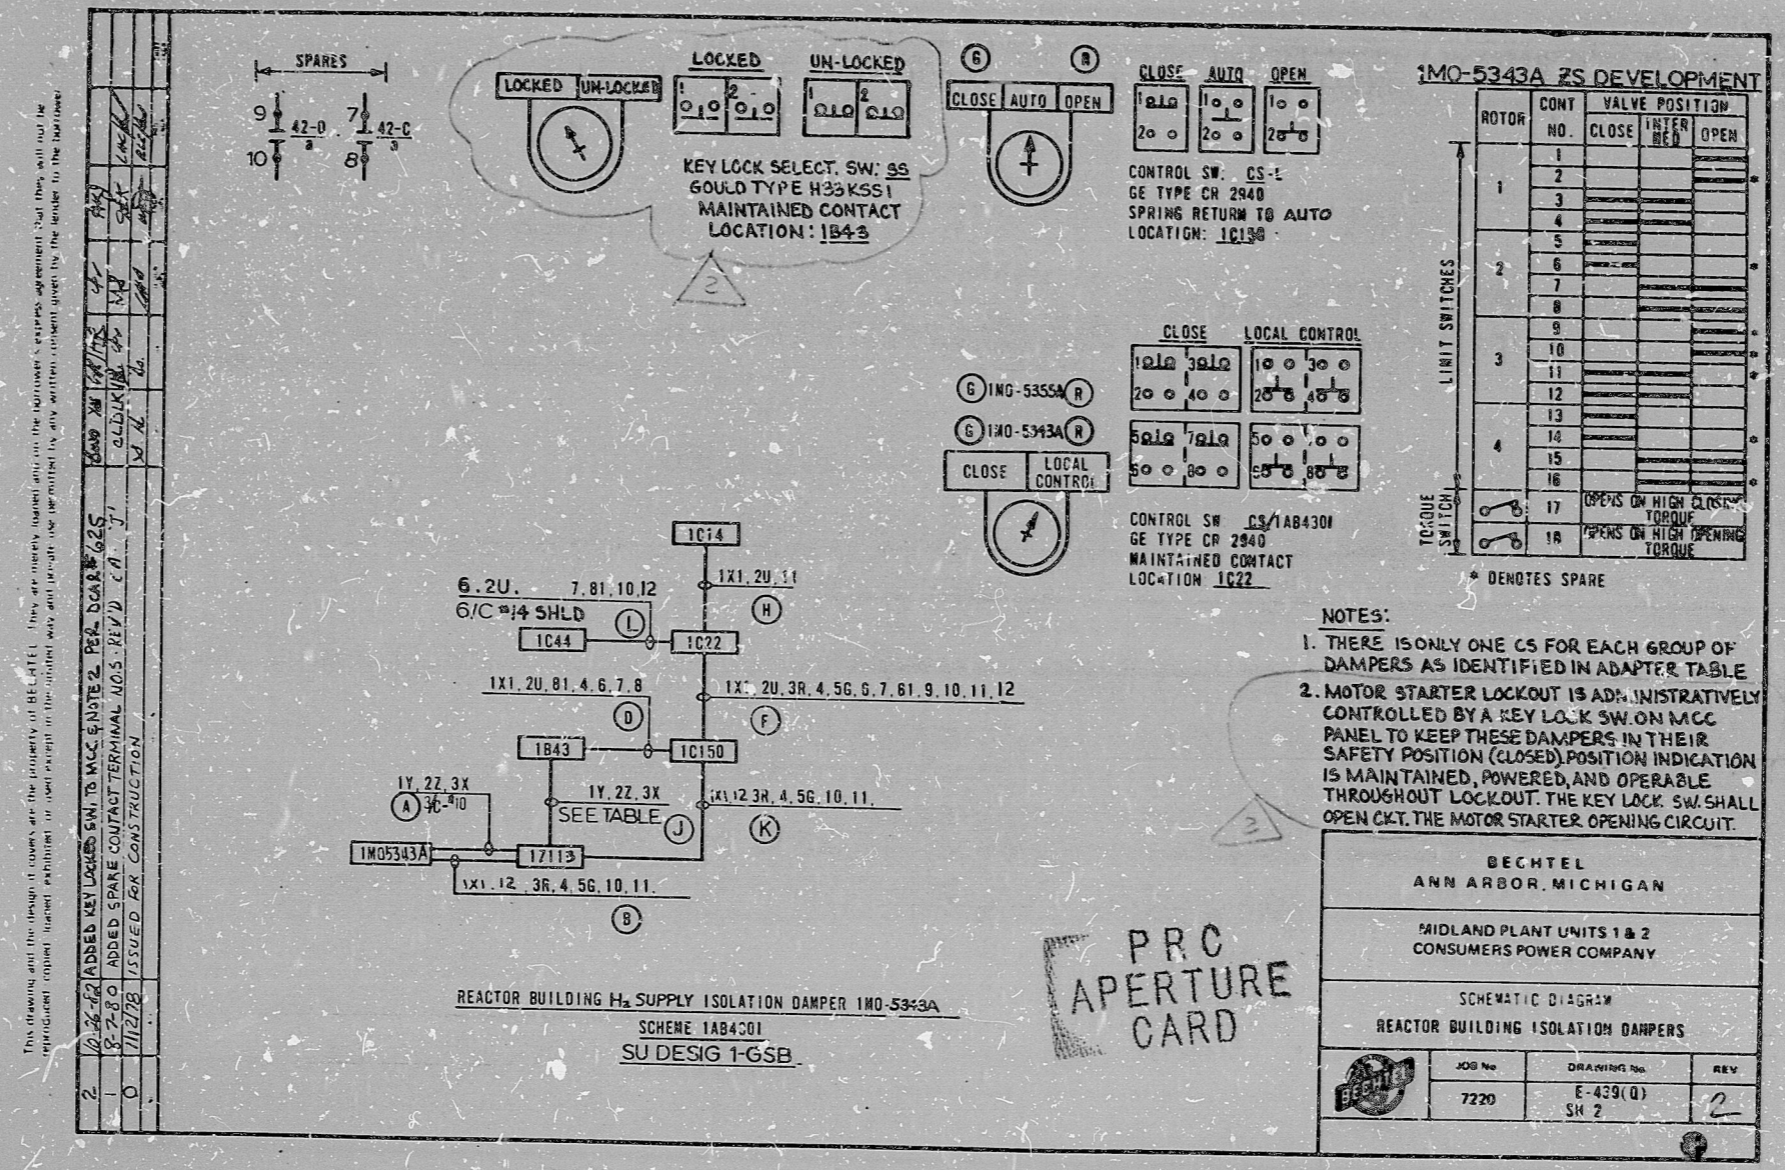

This drawing and the design it covers are the property of BECHTEL. They are hereby loaned and the borrower's express agreement that they will not be reproduced, copied, loaned, exhibited or used except in the limited way and for the use permitted by any written consent given by the lender to the borrower.
 8-7-80 ADDED SPARE CONTACT TERMINAL NOS. REV'D C.A. J.
 0 11/2/78 ISSUED FOR CONSTRUCTION

"I certify that the image contained on this frame was made in the normal and regular course of business, on the date stated below and that it is an accurate reproduction of the document submitted to the contractor for filming, by Bechtel Power Corporation.

11-1-82 DATE
M. Scisoy CAMERA OPERATOR
M. Thomas CONTRACTOR'S SUP'VR. OR MANAGER

16X

RID's

8302090106

