


This drawing and the design it covers are the property of BECHTEL. They are hereby loaned to the borrower's representative agreement that they will not be reproduced, copied, loaned, exhibited, or used except in the limited way and private use permitted by any written consent given by the lender to the borrower.  
 11-1-82 DATE  
 M. C. GOSBY CAMERA OPERATOR  

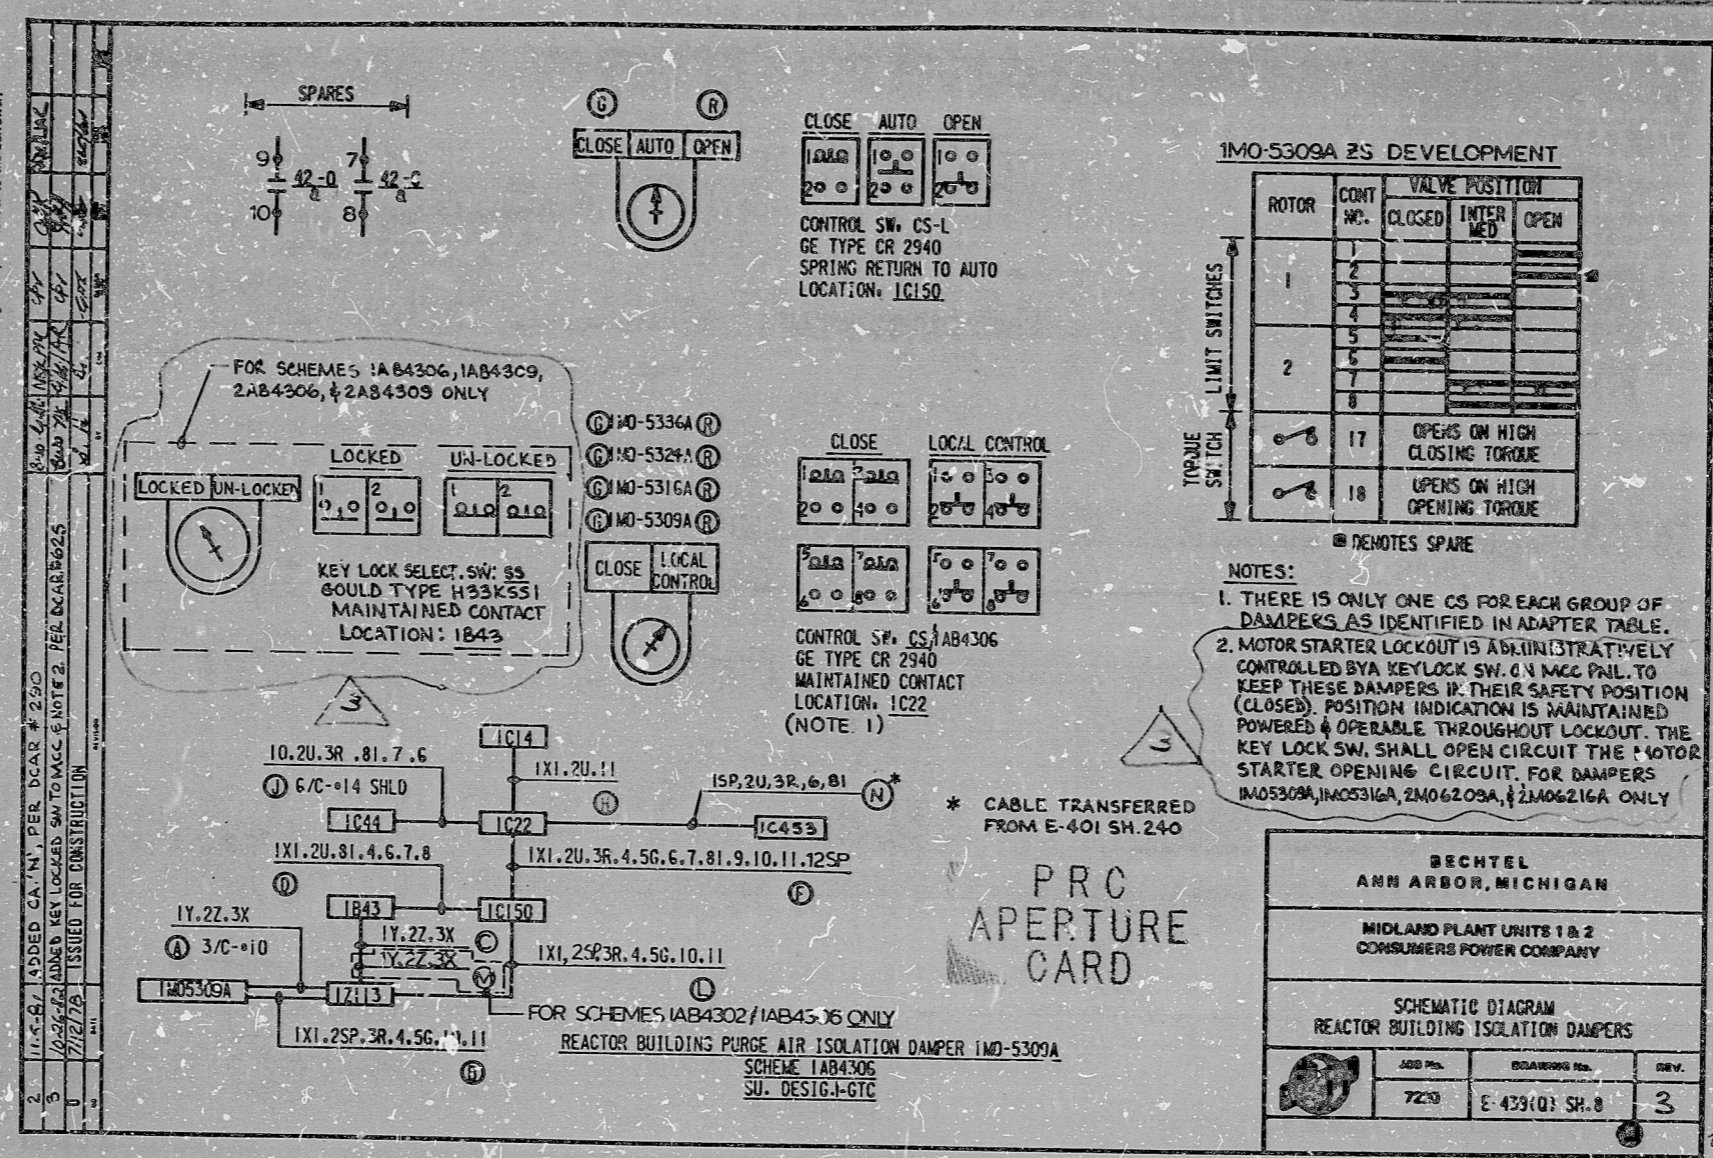

I certify that the image contained on this frame was made in the normal and regular course of business, on the date stated below and that it is an accurate reproduction of the document submitted to the contractor for filming, by Bechtel Power Corporation.  
 11-1-82 DATE  
 M. C. GOSBY CAMERA OPERATOR  
 M. C. GOSBY CONTRACTOR'S SUPERVISOR OR MANAGER

**16X**

BECHTEL ANN ARBOR, MICHIGAN		
MIDLAND PLANT UNITS 1 & 2 CONSUMERS POWER COMPANY		
SCHEMATIC DIAGRAM REACTOR BUILDING ISOLATION DAMPERS		
ADD No.	DRAWING No.	REV.
7230	E 433(0) SH. 8	3

RIDS

8302090114

