

17"

11"

8.5"

8.5"

11"

17"

17"


11"

8.5"

8.5"

11"

17"

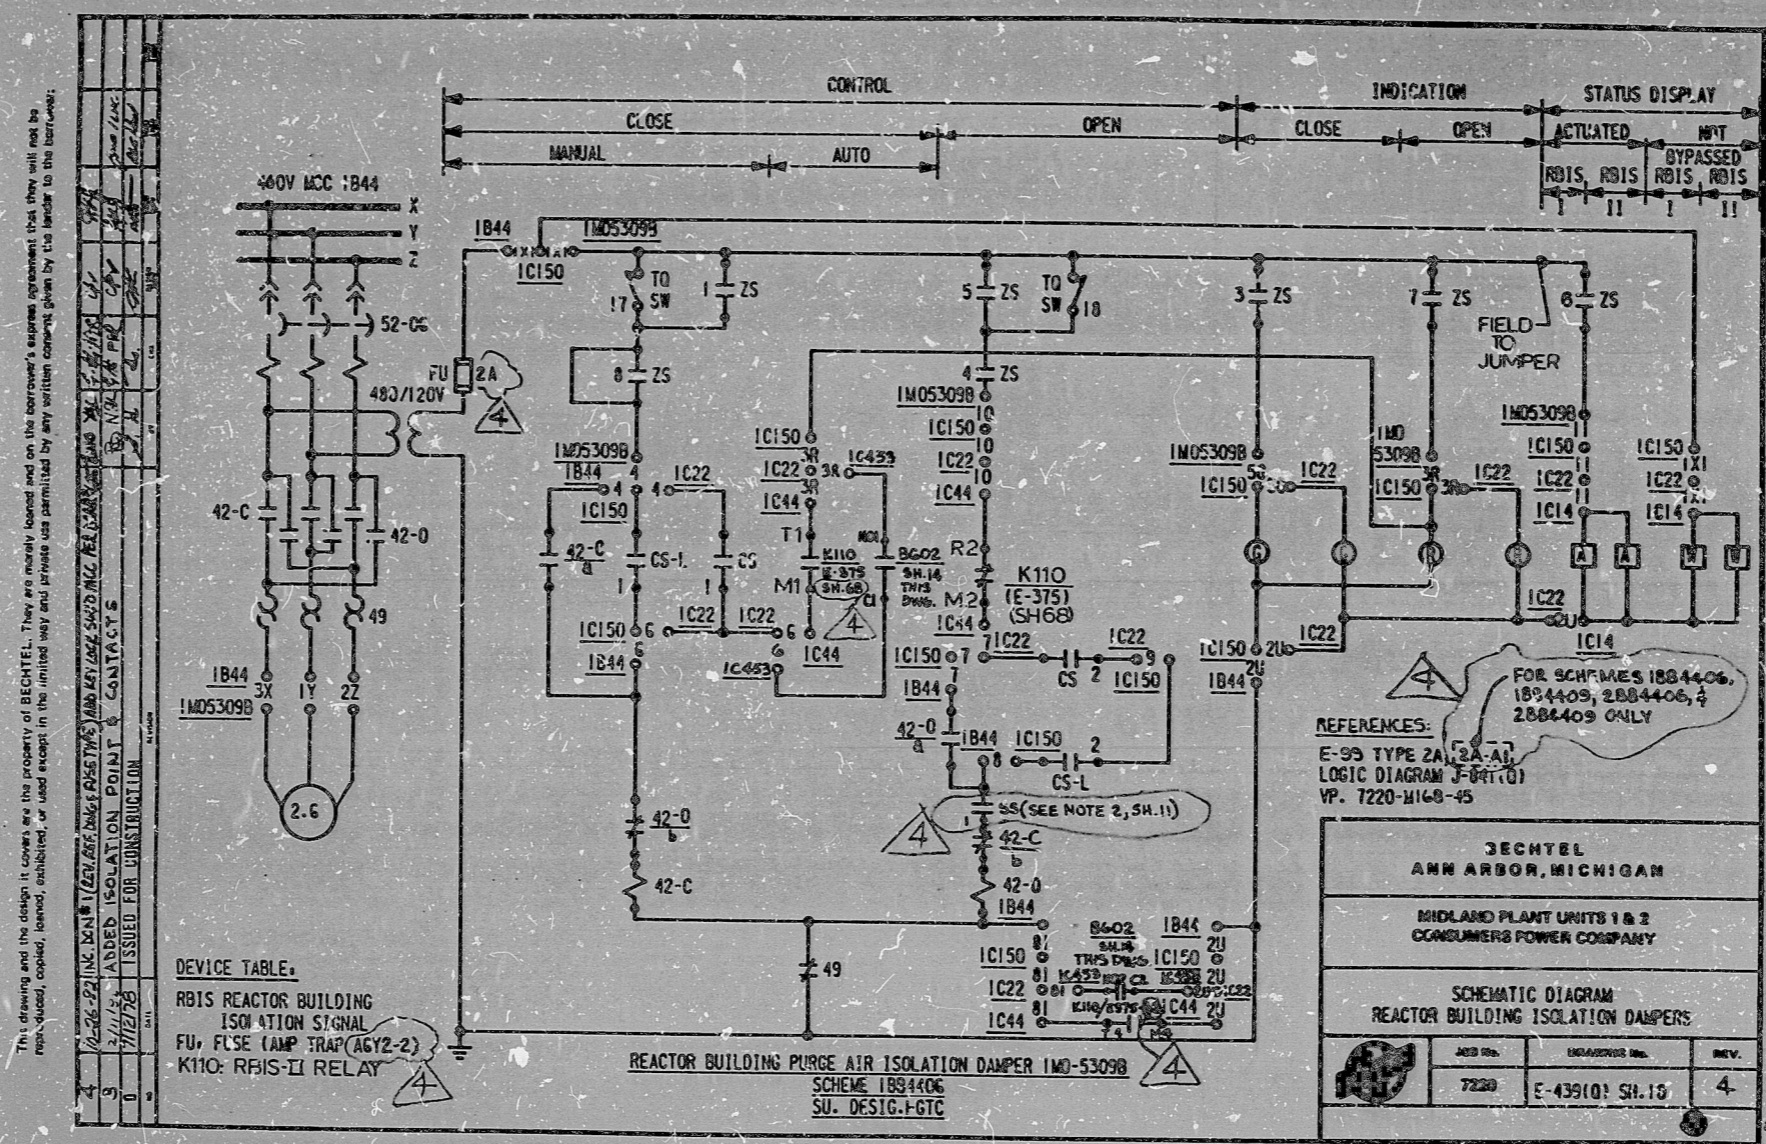

This drawing and the design it covers are the property of BECHTEL. They are hereby loaned to the borrower's expense agreement that they will not be reproduced, copied, loaned, assigned, or used except in the limited way and purpose set forth in the contract given by the lender to the borrower.


11/1/82 M. CSICSOVY

"I certify that the image contained on this frame was made in the normal and regular course of business, on the data stated below and that it is an accurate reproduction of the document submitted to the contractor for filing, by Bechtel Power Corporation."

11-1-82 DATE
 M. CSICSOVY CAMERA OPERATOR
 D. J. Thomas CONTRACTOR'S SUP'VR. OR MANAGER.

16X

PRC APERTURE CARD

RIDS

8302090116

