


This drawing and the design it covers are the property of BECHTEL. They are hereby loaned and on the borrower's express agreement that they will not be reproduced, copied, loaned, exhibited, or used except in the limited way and purpose as permitted by any written consent given by the lender to the borrower.

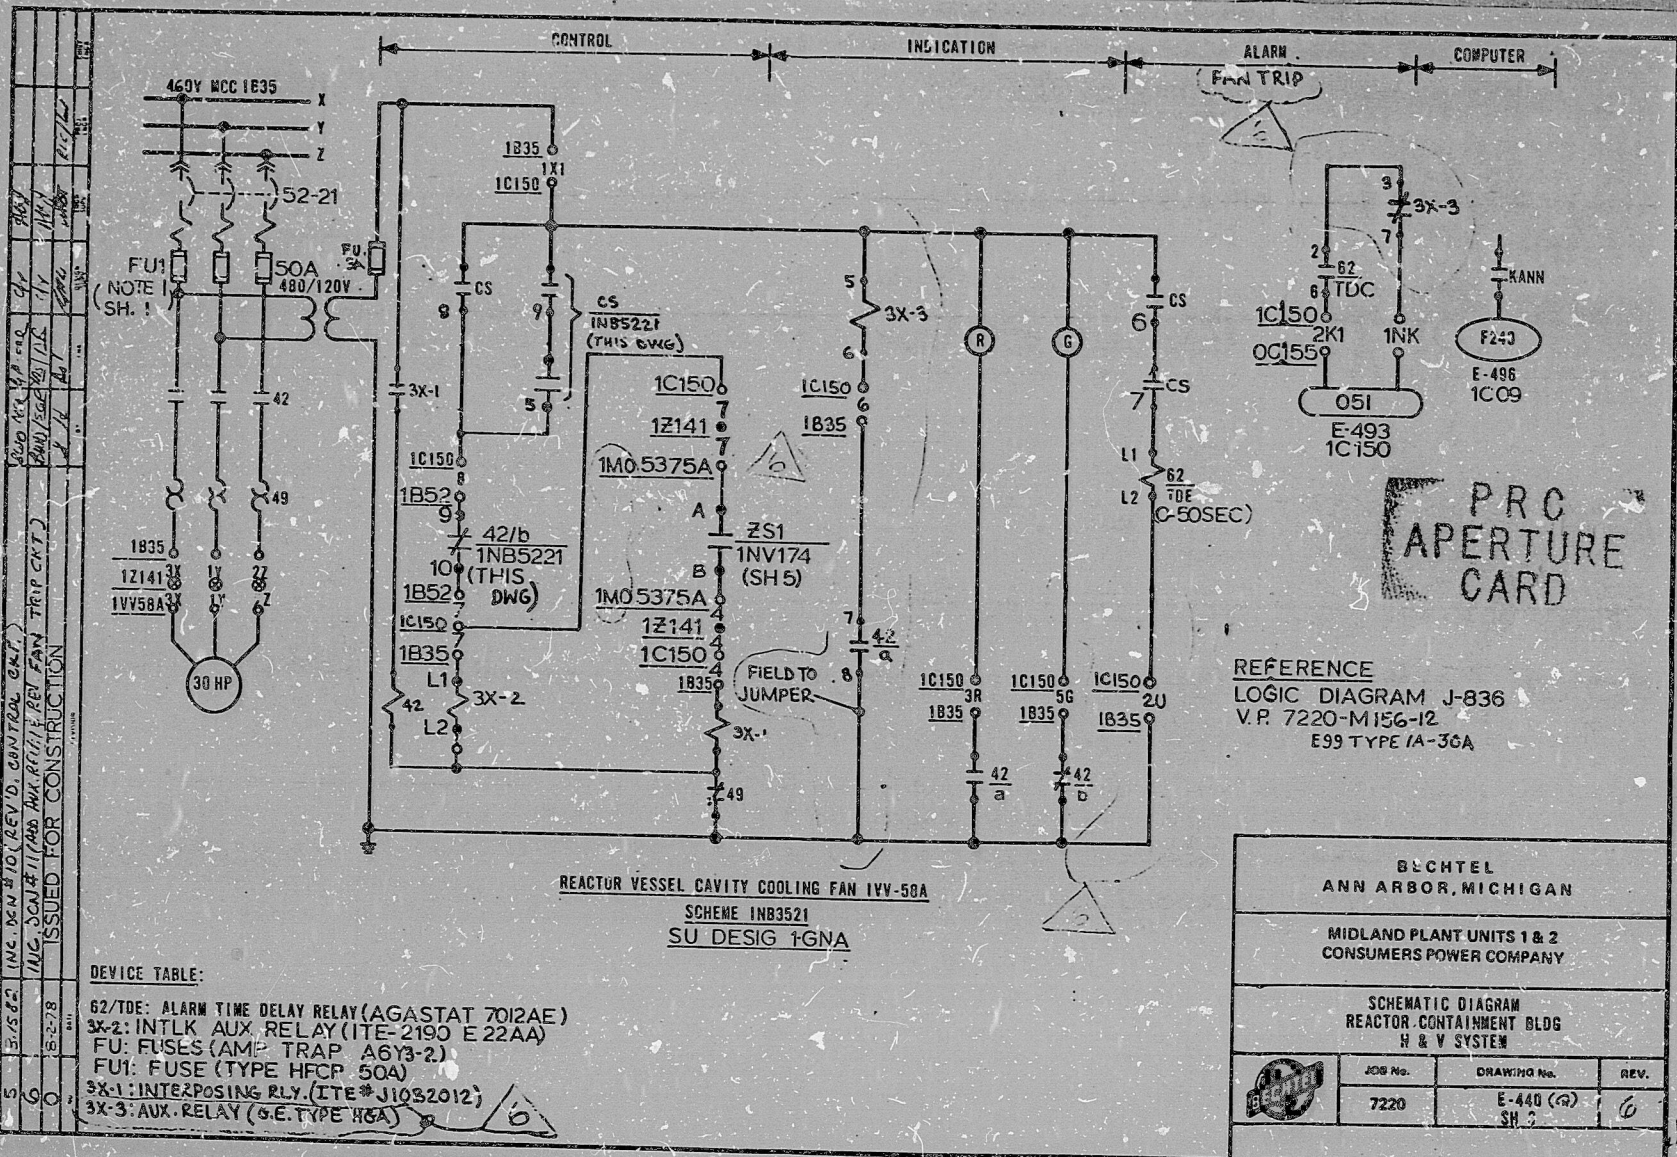

PRC
 APERTURE
 CARD

REFERENCE
 LOGIC DIAGRAM J-836
 V.P. 7220-M156-12
 E99 TYPE (A-30A)

ISSUED FOR CONSTRUCTION


DEVICE TABLE:
 62/TDE: ALARM TIME DELAY RELAY (AGASTAT 7012AE)
 3X-2: INTLK AUX RELAY (ITE-2190 E 22AA)
 FU: FUSES (AME TRAP A6Y3-2)
 FU1: FUSE (TYPE HFCE 50A)
 3X-1: INTERPOSING RLY. (ITE # J1052012)
 3X-3: AUX. RELAY (S.E. TYPE H8A)

BECHTEL ANN ARBOR, MICHIGAN		
MIDLAND PLANT UNITS 1 & 2 CONSUMERS POWER COMPANY		
SCHEMATIC DIAGRAM REACTOR CONTAINMENT BLDG H & V SYSTEM		
	JOB No. 7220	DRAWING No. E-440 (R) SH 3
		REV. 6

RIDS

8302090124

