

17"


11"

8.5"

17"

11"

8.5"

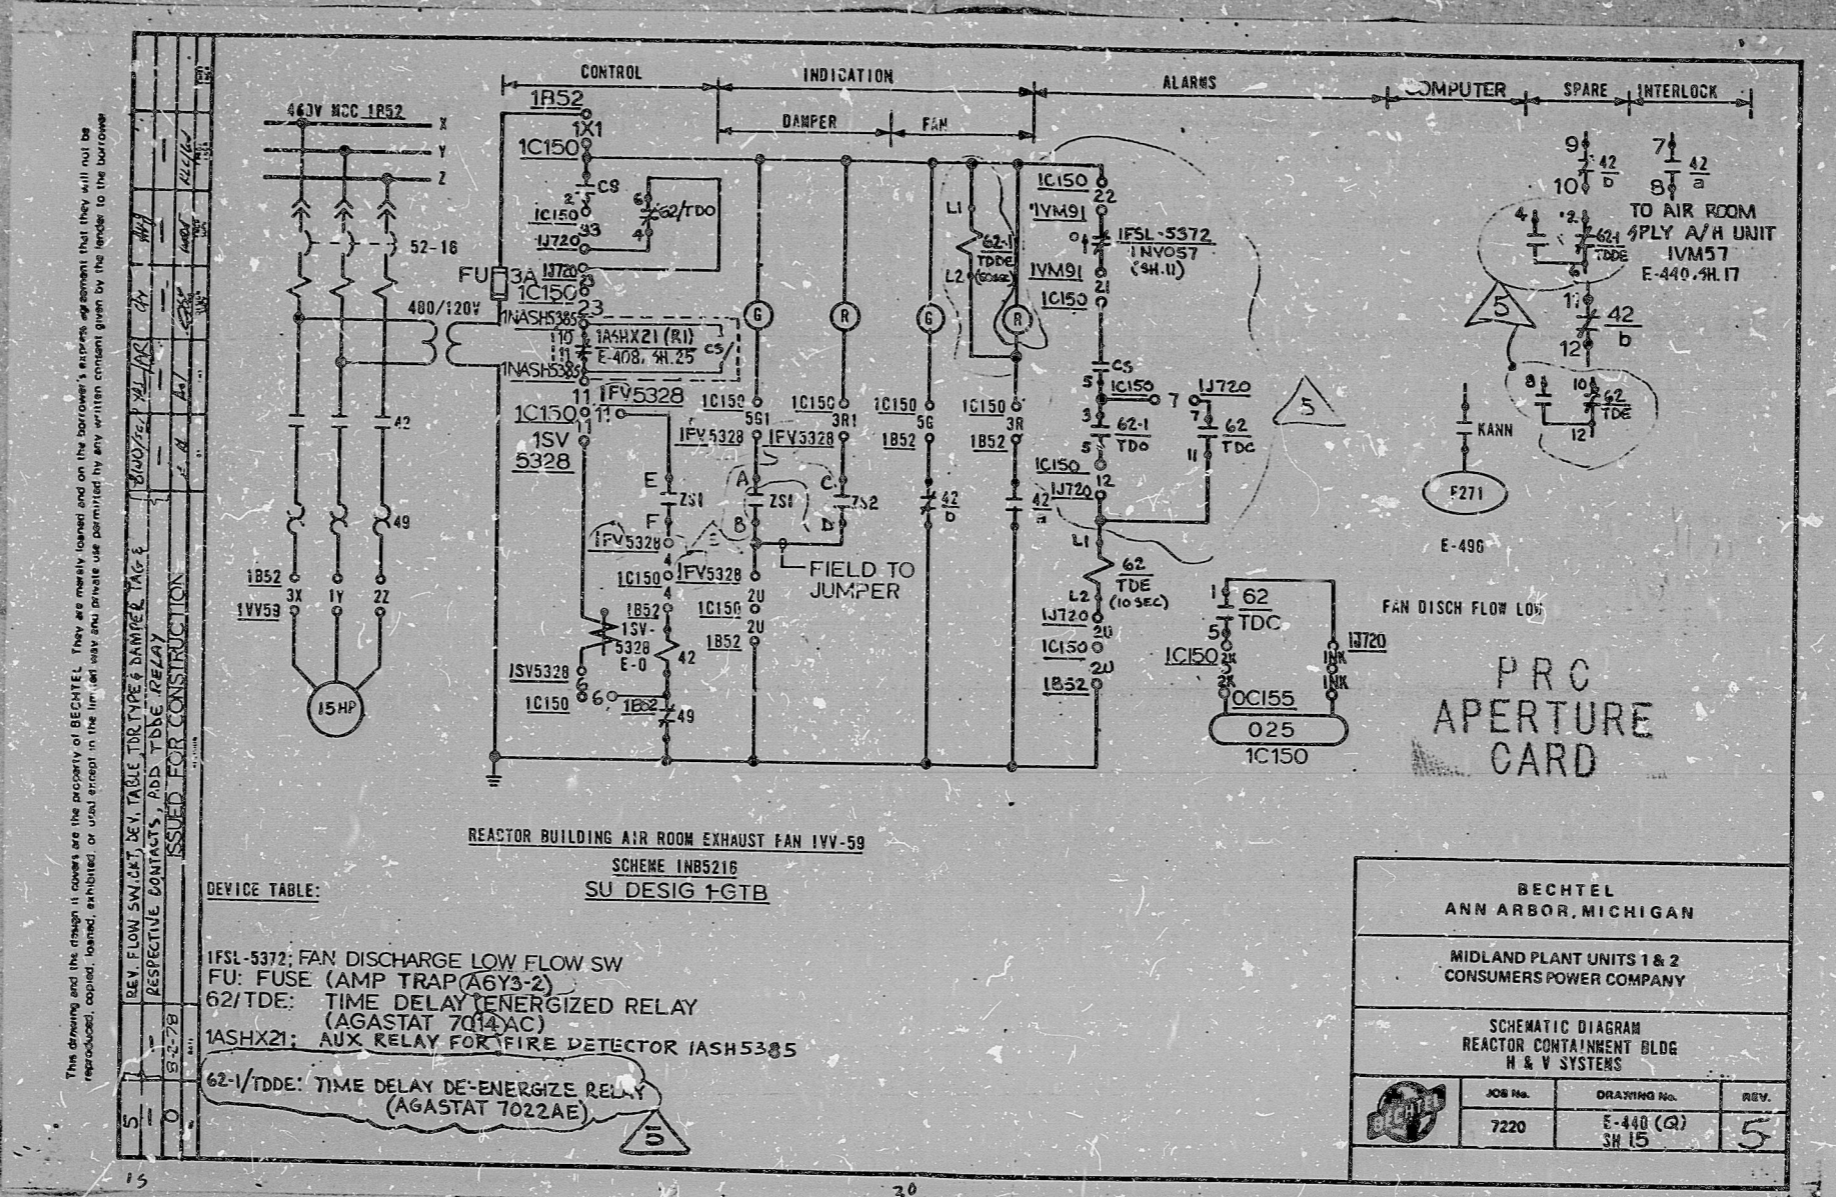

This drawing and the design it covers are the property of BECHTEL. They are hereby loaned and on the borrower's express agreement that they will not be reproduced, copied, loaned, exhibited or used, except in the manner and for the purposes intended, without the written consent of BECHTEL.

| REV. | DATE     | BY  | CHKD. | DESCRIPTION             |
|------|----------|-----|-------|-------------------------|

DEVICE TABLE:

|            |   |
|------------|---|
| 1FSL-5372: | FAN DISCHARGE LOW FLOW SW                     |
| FU:        | FUSE (AMP TRAP) (A6Y3-2)                      |
| 62/TDE:    | TIME DELAY ENERGIZED RELAY (AGASTAT 7014 AC)  |
| 1ASHX21:   | AUX RELAY FOR FIRE DETECTOR IASH5385          |
| 62-1/TDDE: | TIME DELAY DE-ENERGIZE RELAY (AGASTAT 7022AE) |

|  |                                   |           |
|--|-----------------------------------|-----------|
| BECHTEL<br>ANN ARBOR, MICHIGAN                                 |                                   |           |
| MIDLAND PLANT UNITS 1 & 2<br>CONSUMERS POWER COMPANY           |                                   |           |
| SCHEMATIC DIAGRAM<br>REACTOR CONTAINMENT BLDG<br>H & V SYSTEMS |                                   |           |
| JOB No.<br>7220  | DRAWING No.<br>E-440 (G)<br>3H 15 | REV.<br>5 |

8.5"

11"

8.5"

11"

17"

17"

**RIDS**

8302090143

