


This drawing and the design it covers are the property of BECHTEL. They are hereby loaned and on the borrower's extreme agreement that they will not be
 reprinted, copied, loaned, exhibited, or used except in the limited way and for the limited time and for the limited purpose given by the lender. In the borrower's
 possession of this drawing, the borrower agrees to hold BECHTEL harmless from and against all claims, damages, losses, and expenses, including reasonable attorney's
 fees, which may be incurred by BECHTEL as a result of the borrower's use of this drawing.

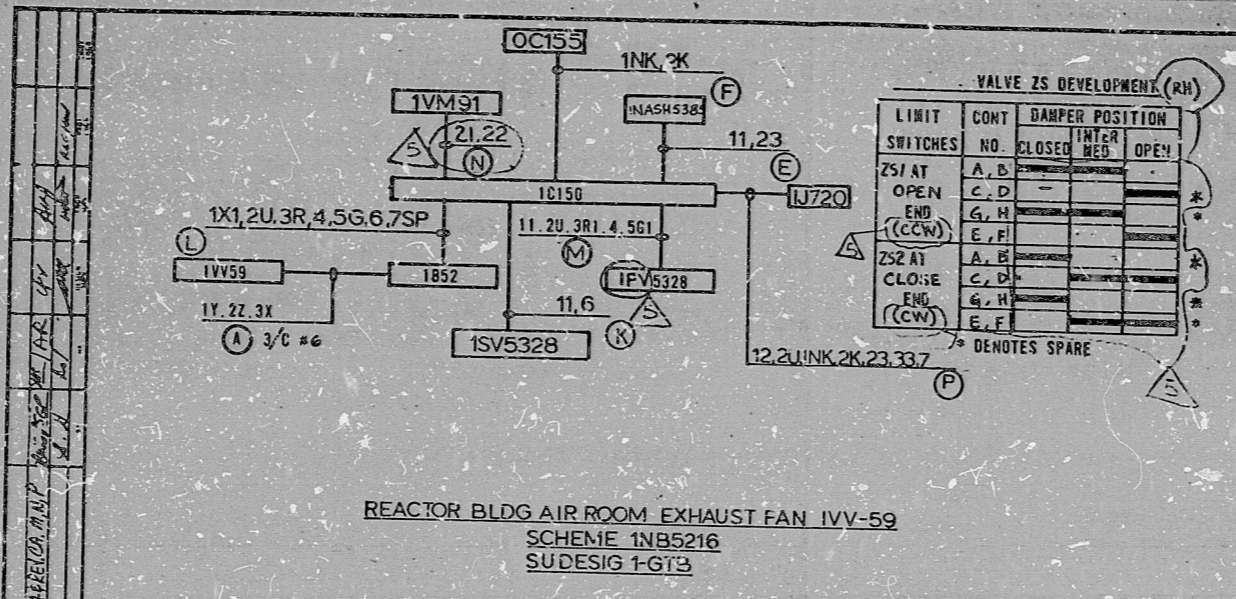

REACTOR BLDG AIR ROOM EXHAUST FAN IVV-59
 SCHEME 1NB5216
 SUDESIG 1-GTB

EQUIPMENT		SCHEME	I/JTLK		FAN DISCH FLOW SW	ANN		COMP I/O
FAN	DAMPER		DETECTOR	AUX. RLY CONTACTS		WND	PNL	
1VV-59	1FV-5328	1NB5216	1A9HXZ1	10.II	1FSL-5372	1C150	F271	
2VV-59	2FV-6228	2NB5216	2A9HXZ1	10.II	2FSL-6772	2C150	F271	

LOCATIONS								SU DESIG	
1852	1C150	1J720	1VM91	1VV59	1FV5328	OC155	1NASH5385		
1852	1C150	1J720	1VM91	1VV59	1FV5328	OC155	1NASH5385	1SV5328	1-GTB
2852	2C150	2J720	2VM91	2VV59	2FV6228	OC155	2NASH6285	2SV6228	2-GTB

VALVE ZS DEVELOPMENT (RH)

LIMIT SWITCHES	CONT NO.	DAMPER POSITION	
		CLOSED	INTER MED OPEN
ZS1 AT OPEN	A, B		
ZS1 AT END (CCW)	C, D		
ZS2 AT CLOSE	E, F		
ZS2 AT END (CCW)	G, H		

RDS

8302090145

