

17

11


8.5

17

11

8.5

This drawing and the design it covers are the property of BECHTEL. They are loaned and on the borrower's express agreement that they will not be reproduced, copied, loaned, exhibited, or used except in the limited way and private use permitted by any written consent given by the lender to the borrower.

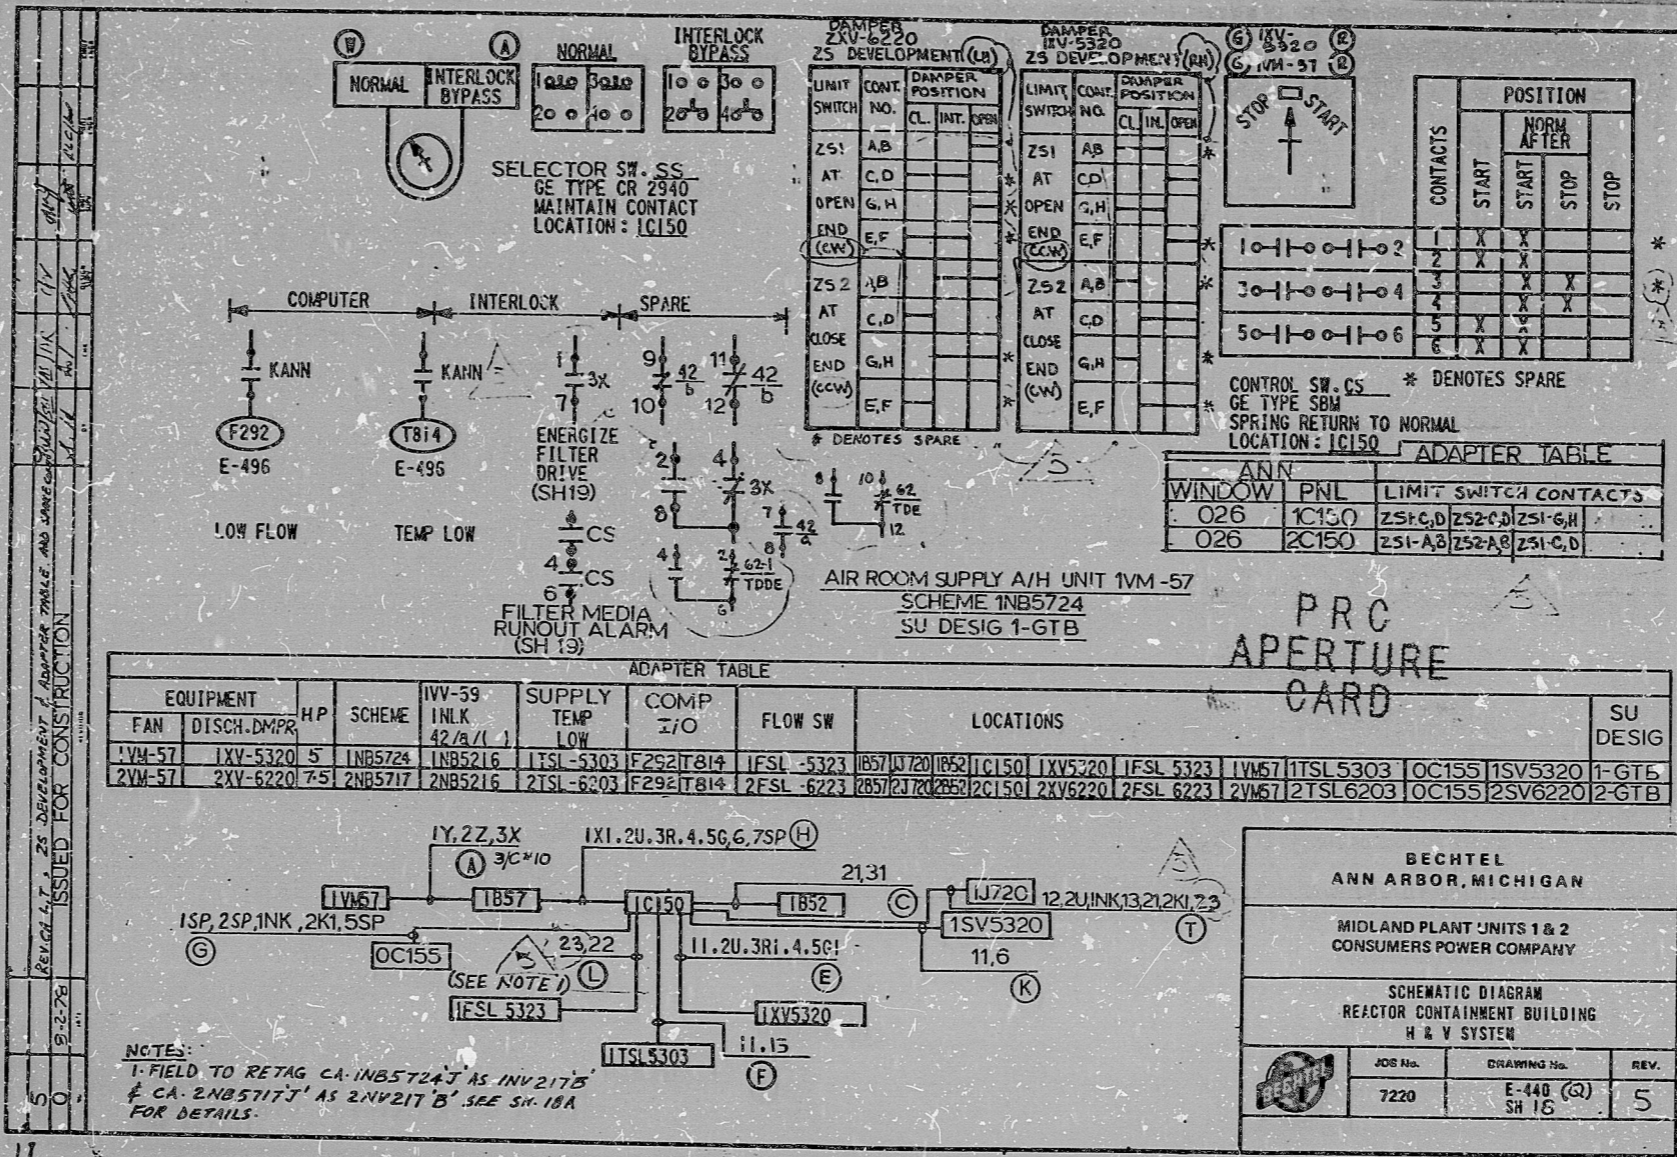

8.5

11

8.5

11

17

17

RIDS

8302090/50

