

17"

11"

8.5"

8.5"

11"

17"

17"


11"

8.5"

8.5"

11"

17"

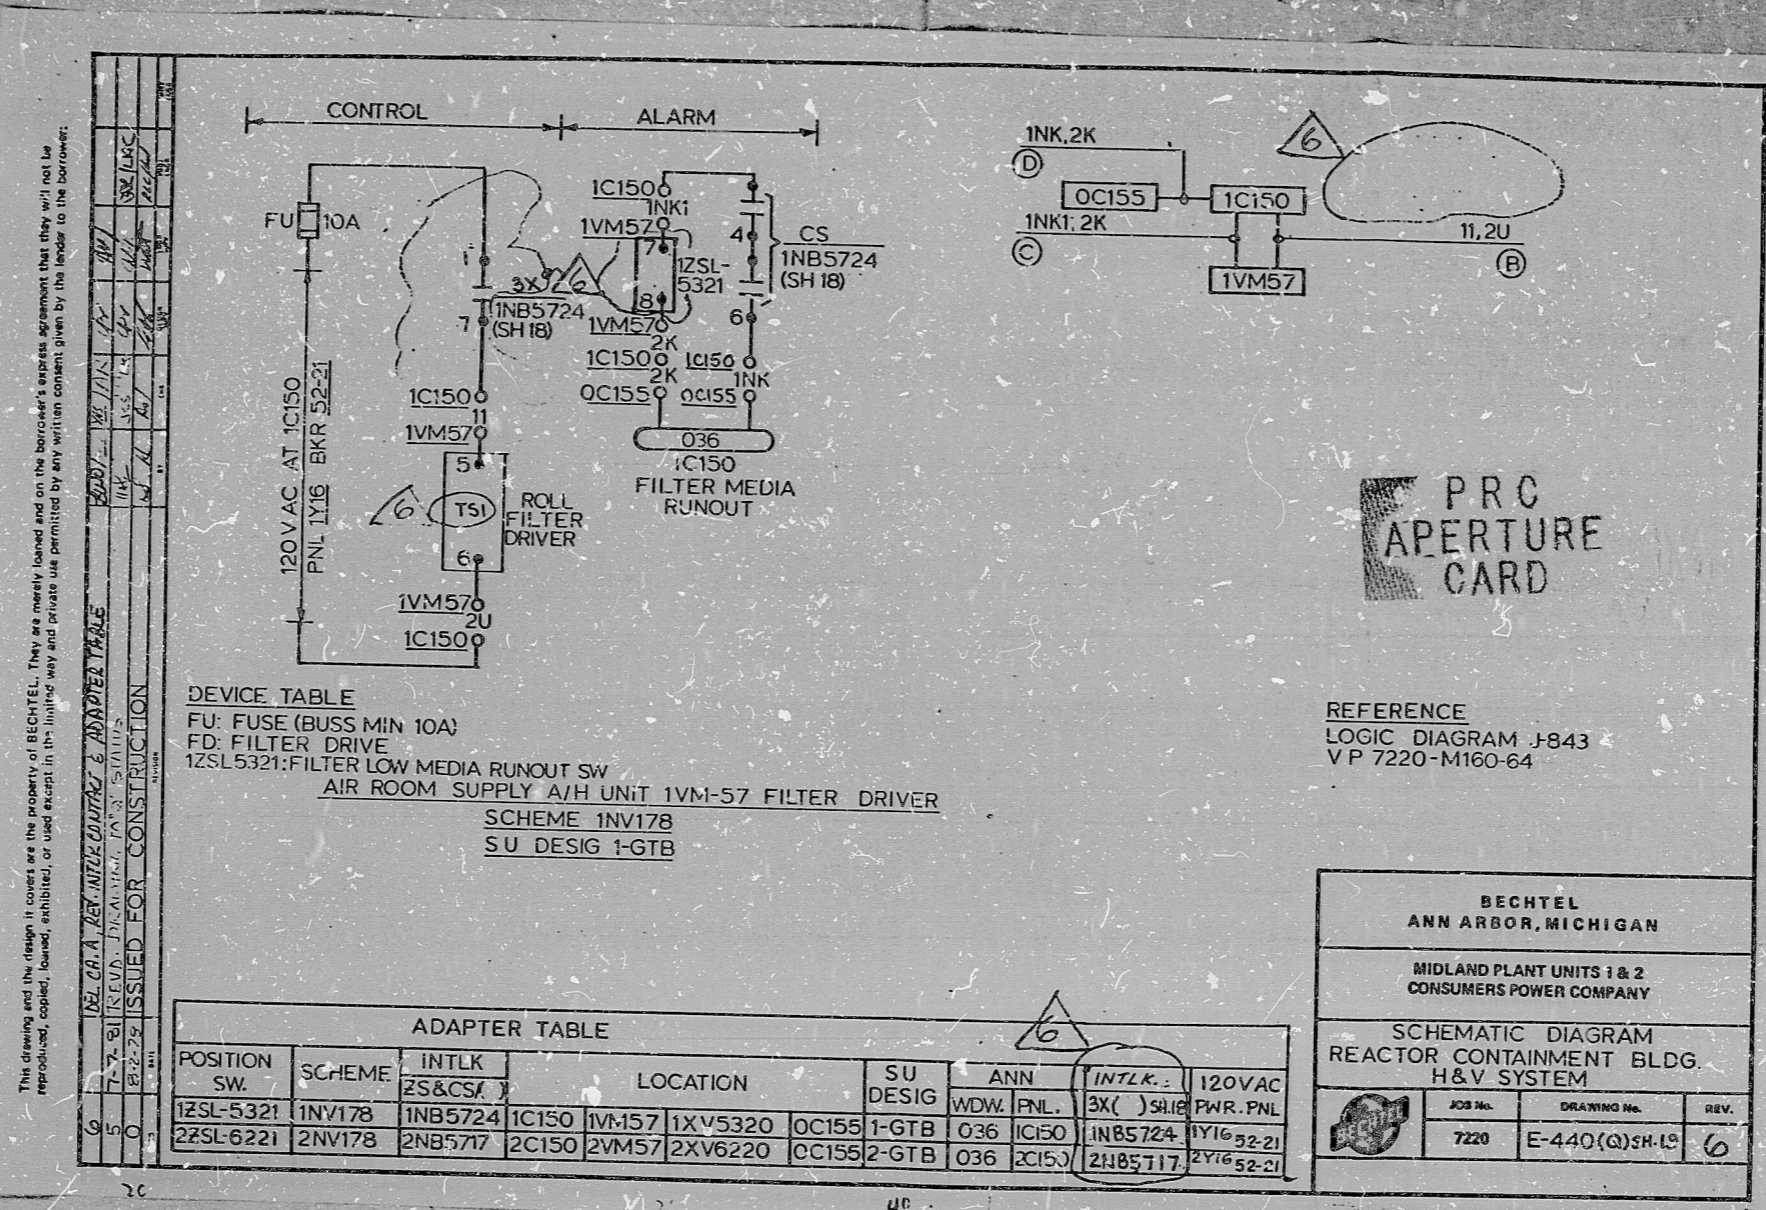

This drawing and the design it covers are the property of BECHTEL. They are hereby loaned and on the borrower's express agreement that they will not be reproduced, copied, loaned, exhibited, or used except in the limiting way and private use permitted by any written consent given by the lender to the borrower.


**DEVICE TABLE**  
 FU: FUSE (BUSS MIN 10A)  
 FD: FILTER DRIVE  
 1ZSL5321: FILTER LOW MEDIA RUNOUT SW  
 AIR ROOM SUPPLY A/H UNIT 1VM-57 FILTER DRIVER  
 SCHEME 1NV178  
 SU DESIG 1-GTB

**REFERENCE**  
 LOGIC DIAGRAM J-843  
 V P 7220-M160-64

ADAPTER TABLE											
POSITION SW.	SCHEME	INTLK	LOCATION			SU DESIG	ANN	INTLK.	120VAC		
1ZSL-5321	1NV178	1NB5724	1C150	1VM57	1XV5320	OC155	1-GTB	036	1C150	1NB5724	1Y16 52-21
2ZSL-6221	2NV178	2NB5717	2C150	2VM57	2XV6220	CC155	2-GTB	036	2C150	2NB5717	2Y16 52-21

BECHTEL ANN ARBOR, MICHIGAN		
MIDLAND PLANT UNITS 1 & 2 CONSUMERS POWER COMPANY		
SCHEMATIC DIAGRAM REACTOR CONTAINMENT BLDG. H&V SYSTEM		
JOB No.	DRAWING No.	REV.
7220	E-440(Q)SH-13	6

RIDS

8302090156

