

17"


11"

8.5"

17"

11"

8.5"

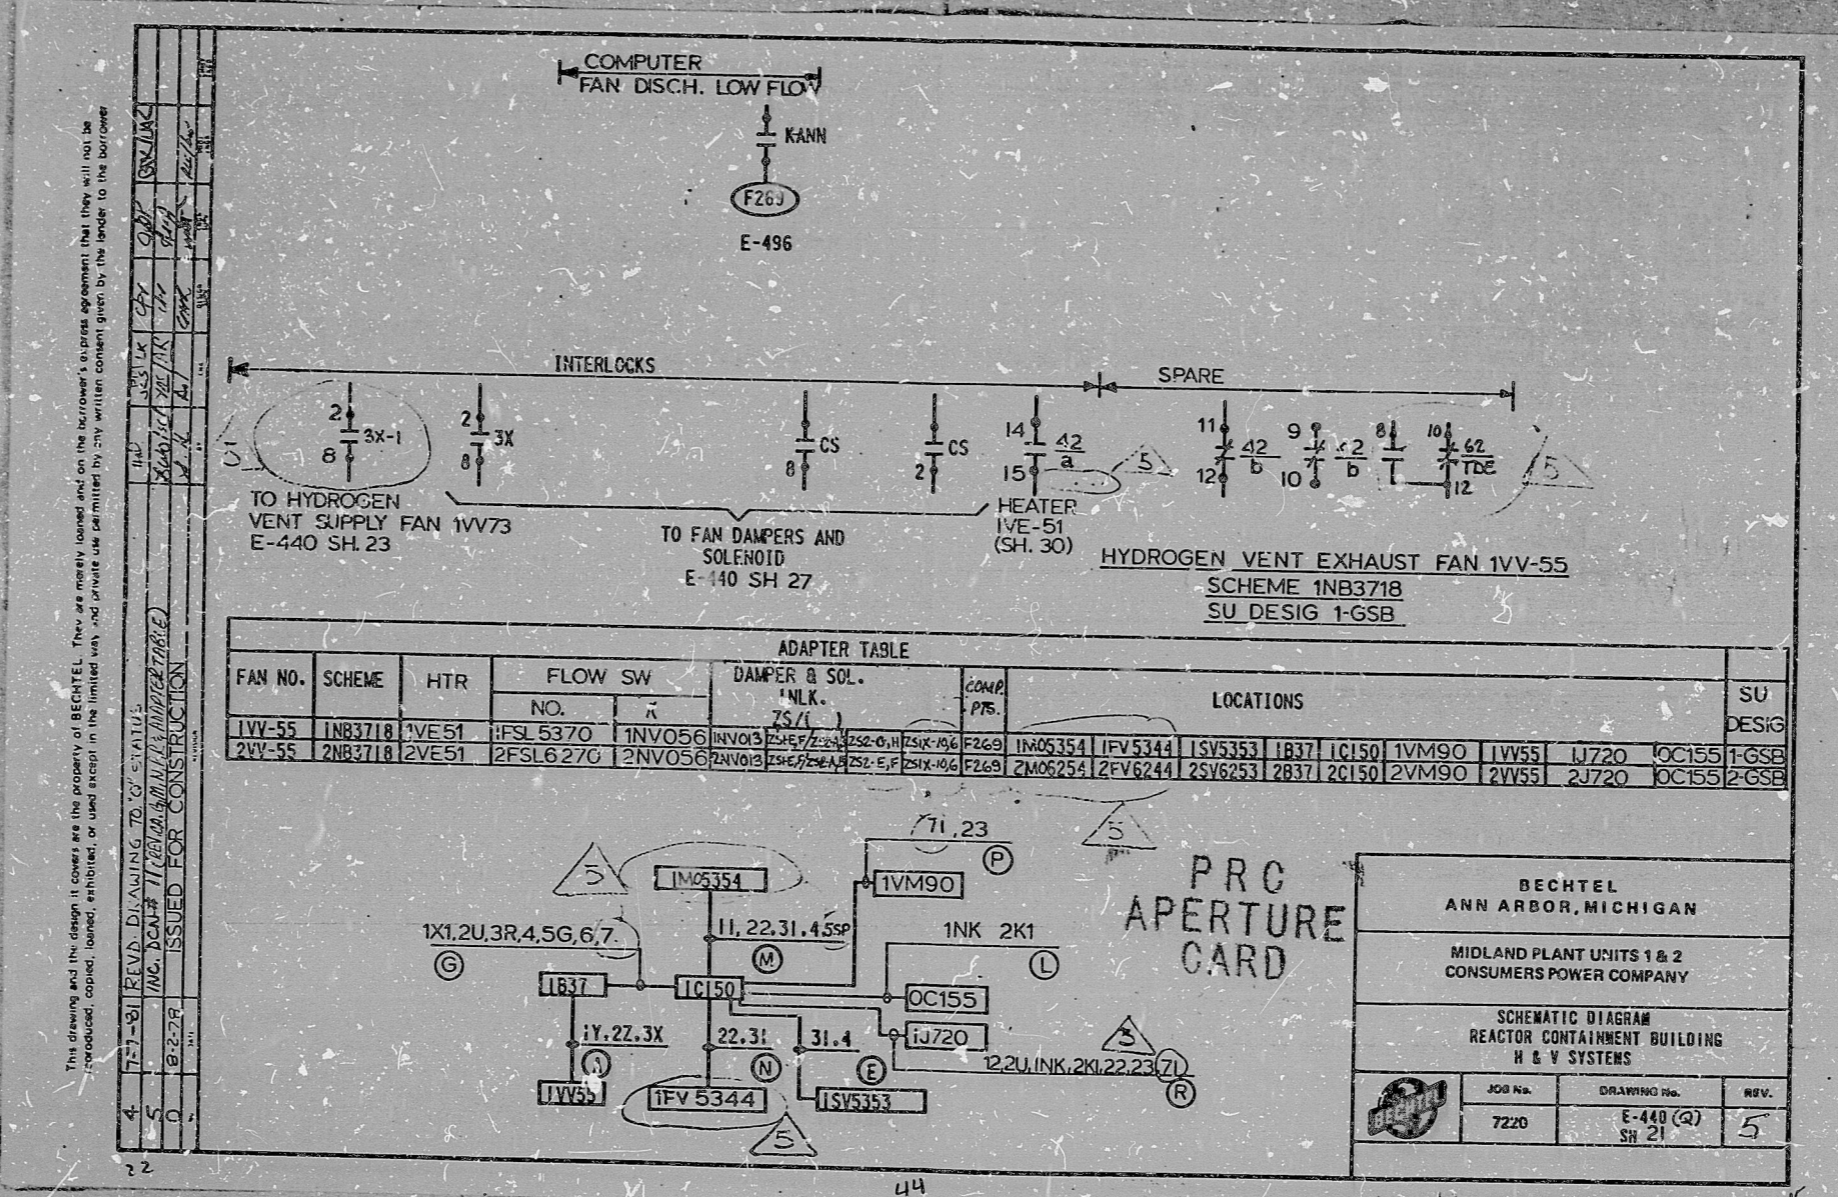

This drawing and the design it covers are the property of BECHTEL. They are hereby loaned to the borrower's express agreement that they will not be reproduced, copied, loaned, exhibited, or used except in the limited way and under the limitations set forth in the written consent given by the lender to the borrower.

REVISED DRAWING TO STATUS


ISSUED FOR CONSTRUCTION

8.5"

11"

17"

8.5"

11"

17"

RIDS

8302090/61

